


Section 7 Township 18 Range 1-WWell No. #1 Burk "B"Company Mallard & Westgate-Greenland

NORTH

WEST

EAST

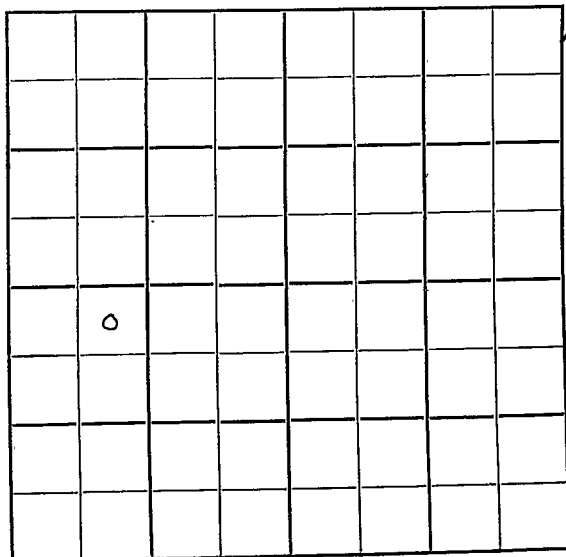

SOUTH

KANSAS

McPherson

Sec. 7 Twp. 18 R. 1-W

Well No. #1 Burk "B" Farm

Mallard & Westgate-Greenland Company

Contractor


330 Ft. from N. Line

Ft. from S. Line

Ft. from E. Line

990 Ft. from W. Line

NE NW SW

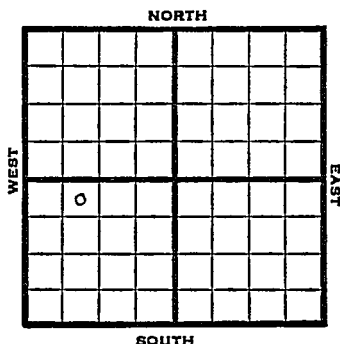

1950

REPORT

7/26

Miss 2828-39
5" @ 2824
TD 2876
HFW
D&A

FIRST REPORT
X
ABANDONED

Kansas

Map No. _____ Sec. 7 Twp. 18 R. 1WWell No. 1 Burk "B"Mallard & Westgate-Greenland Company

Contractor

NE NW SW

E1 1459
SECTION PLAT

330

Ft. from N. Line

Ft. from S. Line

Ft. from E. Line

990

Ft. from W. Line

FIRST REPORT
ABANDONEDMcPherson County

Location _____

Rig up _____

Drilling and Remarks:

Miss. 2828-39

5" @ 2824

TD 2876

HFW

D & A

RECORD

Cased _____ in., _____ ft.

Sand _____

Gas _____

Oil _____

Total Depth 2876

PRODUCTION

1st 24 hrs. Nat. _____

1st 24 hrs. after shot _____

Gas _____ Cu. Ft.

Dry Hole _____


Abandoned _____

Date

JUL 26 1950 19J. E. TYRA

Scout

County McPherson State Kansas
 Sec. 7 (Blk.) 18 (Sur.) 1W Map No.
 Operator Mallard & Westgate-Greenland
 Well No. 1 Farm Burk "B"
 Elev. 1459 Location NE NW SW

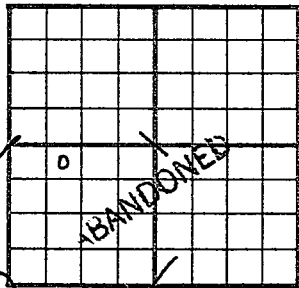

330 Ft. From N Line SW
990 Ft. From W Line Quarter
1st. Report 6-28-50
Completion 7-26-50
 Remarks

Spudding Date 6-27-50
Drig. Data D & A TD 2876

Miss. 2828-39 5" @ 2824 TD 2848

Scum of oil Shut down 12 hr.

FU 300' water DD 2876 HFW

D & A

Duplicate

J. E. TYRA


4-10-1950

_____ 4 11 _____ 11 11

Please check we show a dry hole
close by. Advise
Sam

10 1 11 11

7 1 11 11

 

11 1 11 11

11 1 11 11

AUG 7 1950

Scout Cards	7-11
Land Small Map	
Land Wall Map	
Tracings	
France Map	
Pierce Map	
Misc.	