


Section 7 Township 18 Range 1W

Well No. 2 Crane

Company Westgate-Greenland

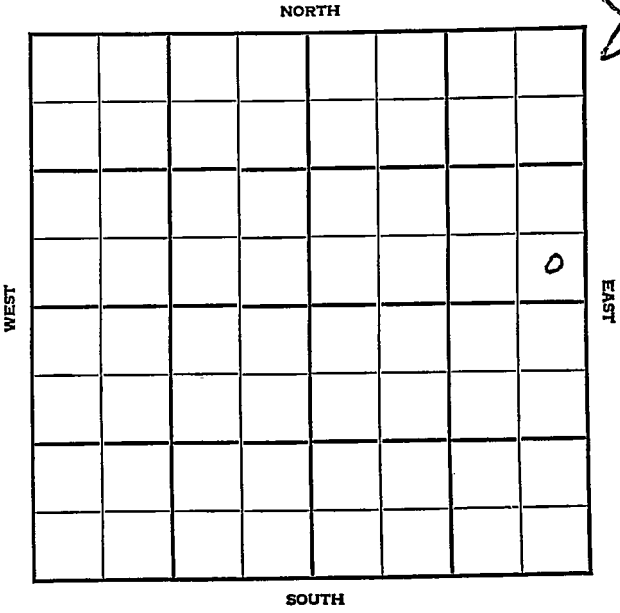

Sec. 7 Twp. KANSAS 18 R. 1W

Well No. #2 Crane Farm  
Westgate-Greenland Company

Jirod Pool


\_\_\_\_\_ Ft. from N. Line

330' Ft. from S. Line

330' Ft. from E. Line

\_\_\_\_\_ Ft. from W. Line

SE NE

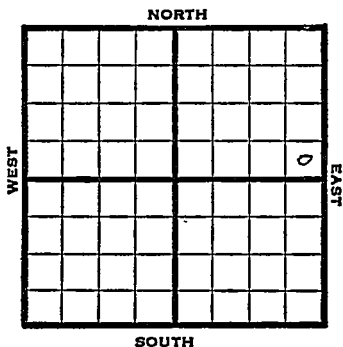

1948

Elev. 1388' REPORT

- 5/12 Location
- 5/19 Mississippi 2726'  
5" @ 2726'  
TD 2735'  
SO
- 5/26 TD 2739' - 3000 Acid
- 6/1 "
- 6/9 Miss. 2726'  
5" @ 2726'  
3000 acid  
Pump 165 oil Pot  
38.0 Gr.  
TD 2739'  
Comp.

**COMPLETED**

Map No. \_\_\_\_\_ Sec. 7 Twp. 18 R. 1W

Well No. 2 Crane

Westgate-Greenland Company

**FIRST REPORT**

Contractor

SE NE

SECTION PLAT

\_\_\_\_\_ Ft. from N. Line

330 Ft. from S. Line

330 Ft. from E. Line

\_\_\_\_\_ Ft. from W. Line

			o

McPherson County

Location X

Rig up \_\_\_\_\_

Drilling and Remarks: \_\_\_\_\_

RECORD

Cased \_\_\_\_\_ in., \_\_\_\_\_ ft.

Sand \_\_\_\_\_

Gas \_\_\_\_\_

Oil \_\_\_\_\_

Total Depth \_\_\_\_\_

PRODUCTION

1st 24 hrs. Nat. \_\_\_\_\_

1st 24 hrs. after shot \_\_\_\_\_

Gas \_\_\_\_\_ Cu. Ft.

Dry Hole \_\_\_\_\_

Abandoned \_\_\_\_\_

Date

MAY 1 2 1948

19

S. J. LEWIS Scout

Map No. 42 Sec. 7 Twp. 18 R. 1W

Well No. 2 Crane

Westgate-Greenland Company

**COMPLETE**

Contractor

SE NE

*E. 1388*

SECTION PLAT

\_\_\_\_\_ Ft. from N. Line  
330 Ft. from S. Line  
330 Ft. from E. Line  
\_\_\_\_\_ Ft. from W. Line

			Δ

McPherson County

Location \_\_\_\_\_

Rig up \_\_\_\_\_

Drilling and Remarks:

*Miss 2726*  
*5' @ 2726*  
*3000 acid*  
*Pump 165 oil Prod*  
*0826*

RECORD

Cased \_\_\_\_\_ in., \_\_\_\_\_ ft.  
Sand \_\_\_\_\_  
Gas \_\_\_\_\_  
Oil  \_\_\_\_\_  
Total Depth 2288

PRODUCTION

1st 24 hrs. Nat. \_\_\_\_\_  
1st 24 hrs. after shot \_\_\_\_\_  
Gas \_\_\_\_\_ Cu. Ft.  
Dry Hole \_\_\_\_\_  
Abandoned \_\_\_\_\_

Date

JUN 9 1948

S. J. LEWIS

Scout