

Sec. 8 Twp. 18 R. 1W

Well No. #1 W. Harmon Farm

Amerada Company


Baden

330 Ft. from N. Line

_____ Ft. from S. Line

330 Ft. from E. Line

_____ Ft. from W. Line

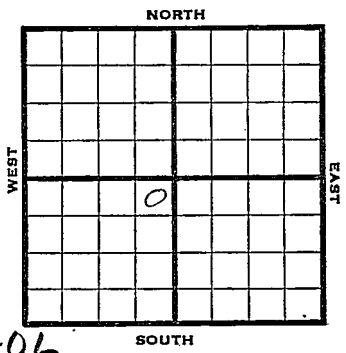

Elev. 1406

NE SW

R E P O R T

1944

10/25 Location

11/1 "

11/8 10" @ 187'
Drlg. 1355'

11/16 Lans 2184

Lost' circulation @ 2680'

11/22 Miss. 2802

TD 2818'

No shows

ABANDONED

Pool Name BadenMap No. KANSAS Sec. 8 Twp. 18 R. 1WWell No. 1 W. HarmonAmerada

Company

FIRST REPORT

Contractor

NE SW


SECTION PLAT

330 Ft. from N. Line

Ft. from S. Line

330 Ft. from E. Line

Ft. from W. Line

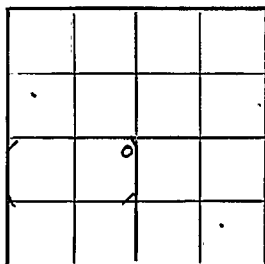McPherson

RECORD

Location X

Rig up _____

Drilling and Remarks:

Cased _____ in., _____ ft.

Sand _____

Gas _____

Oil _____

Total Depth _____

PRODUCTION

1st 24 hrs. Nat. _____

1st 24 hrs. after shot _____

Gas _____ Cu. Ft.

Dry Hole _____

Abandoned _____

Date

OCT 25 1944 19S. J. LEWIS Scout

Pool Name BadenMap No. 42 Sec. 8 Twp. 18 R. 1WWell No. 1 W. HarmonAmerada

Company

ABANDONED

Contractor

NE SW

SECTION PLAT

330 Ft. from N. Line

_____ Ft. from S. Line

330 Ft. from E. Line

_____ Ft. from W. Line

	6		

McPherson

Location _____

Rig up _____

Drilling and Remarks:

Mis 2802No show

RECORD

Cased _____ in., _____ ft.

Sand _____

Gas _____

Oil _____

Total Depth 2878

PRODUCTION

1st 24 hrs. Nat. _____

1st 24 hrs. after shot _____

Gas _____ Cu. Ft.

Dry Hole _____

Abandoned _____

Date

NOV 22 1944 19S. J. LEWIS Scout