


Section 9 Township 18 Range 1W

Well No. #1 Hart

Company Republic Nat. et al

132

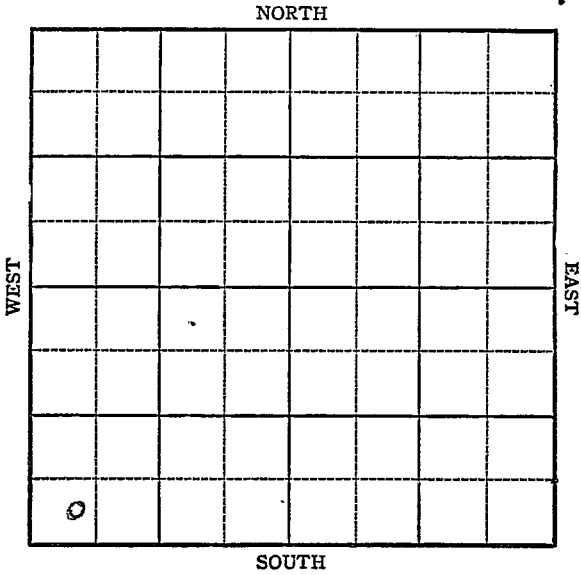

Sec. 9 Twp. 18 R. 1W

Well No. #1 Hart Farm

Republic Nat. et al Company

Baden


 Ft. from N. Line

330 Ft. from S. Line

 Ft. from E. Line

450 Ft. from W. Line

SW/c Elev. 1443

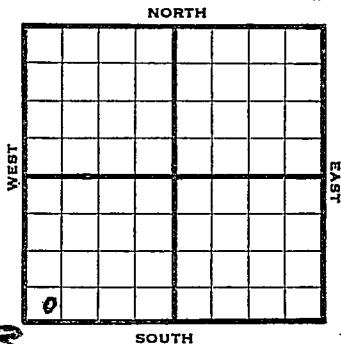

1945

R E P O R T

- 2/14 Location
- 2/21 "
- 2/28 8^u @ 147
Drlg 1015
- 3/7 Drlg 2605
- 3/14 Lāns 2280
Miss 2766
TD 2794

ABANDONED

Pool Name BadenMap No. K-42 Sec. 9 Twp. 18 R. 1WWell No. 1 HartRepublic Nat. etal Company

FIRST REPORT

SW/c Contractor

SECTION PLAT

 Ft. from N. Line330 Ft. from S. Line Ft. from E. Line450 Ft. from W. Line

Mc PhersonLocation XRig up

Drilling and Remarks:

RECORD

Cased in., ft.Sand Gas Oil Total Depth

PRODUCTION

1st 24 hrs. Nat. 1st 24 hrs. after shot Gas Cu. Ft.Dry Hole Abandoned

Date

FEB 14 1945 19S. J. LEWIS Scout

