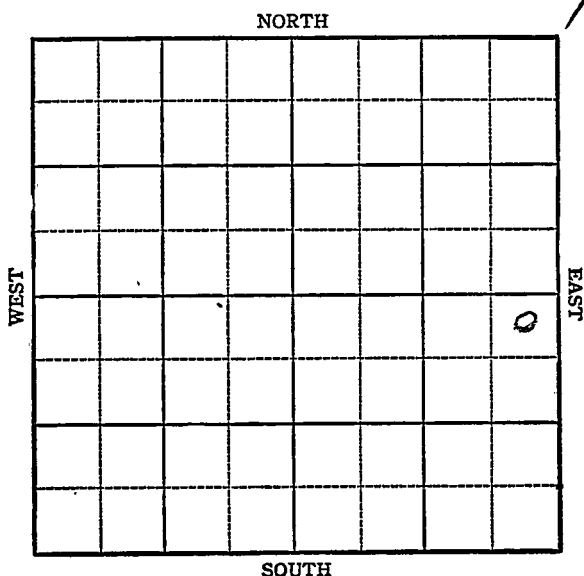


KANSAS

McPherson

FORM 51 5M BRIX


Section 9 Township 18 Range 1WWell No. #1, SteinCompany F. Koch

KANSAS

McPherson County

Sec. 9 Twp. 18 R. 1WWell No. #1 Stein FarmF. Koch Company

Baden

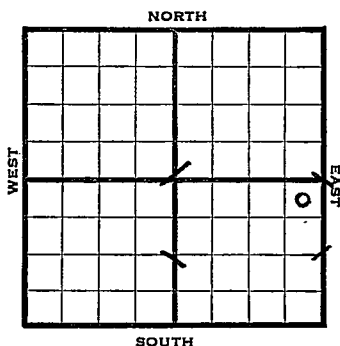330 Ft. from N. Line Ft. from S. Line330 Ft. from E. Line Ft. from W. LineElev. 1388

1944

REPORT

7/12 Loc.
 7/19 8" @ 149 Drlg 1400
 7/26 Lens 2145
 Miss. 2701 -08 TD Sat.
 8/2 TD 2710 SS0 & wtr.
 8/9 " " " " "
 8/16 TD 2718 500 acid Pump $9\frac{1}{2}$ fluid per
 hr 10% wtr.
 8/23 " " " " " " " W " "
 8/30 Miss 2701
 5" @ 2702
 500 acid
 pump 106 oil plus 17% wtr pot.
 TD 2718
 Grav. 39.

COMPLETED

Pool Name Baden

~~KANSAS~~
 Map No. 7 Sec. 9 Twp. 18 R. 1W

Well No. 1 Stein

F. Koch

Company

FIRST REPORT

Contractor

NE SE


SECTION PLAT

330 Ft. from N. Line

Ft. from S. Line

330 Ft. from E. Line

Ft. from W. Line

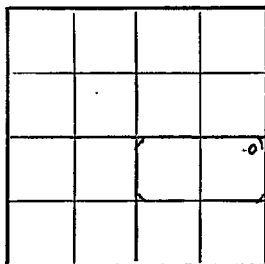

McPherson County

RECORD

Location XCased in., ft.Rig up Sand

Drilling and Remarks:

Gas Oil Total Depth

PRODUCTION

1st 24 hrs. Nat. 1st 24 hrs. after shot Gas Cu. Ft.Dry Hole Abandoned

Date

JUL 12 1944

19

S. J. LEWIS

Scout

Pool Name Baden PoolMap No. 42 Sec. 9 Twp. 18 R/WWell No. 1 SteinF. Koch CompanyCOMPLETED Contractor

NE SE

SECTION PLAT

330 Ft. from N. Line Ft. from S. Line330 Ft. from E. Line Ft. from W. Line

			0

McPherson County

Location Rig up

Drilling and Remarks:

*Miss 2701**5" @ 2702.**500 acid**Pump 106 oil + 17% W.**Bot.**39 e lu*

RECORD

Cased in., ft.Sand Gas Oil Total Depth 2718.

PRODUCTION

1st 24 hrs. Nat. 1st 24 hrs. after shot Gas Cu. Ft.Dry Hole Abandoned

Date

AUG 30 1944 19 S. J. LEWIS Scout