


DX 78-1

McPherson KANSAS

Section 9 Township 18 Range 1W

Well No. 2 Stein

Company Bennett & Roberts

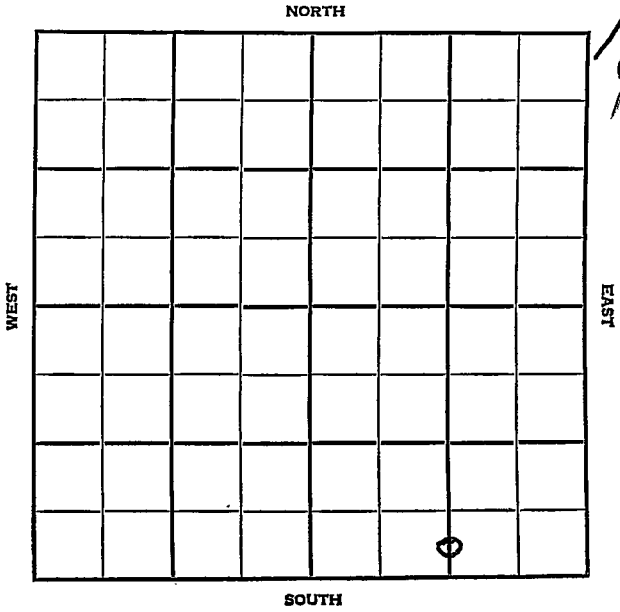

McPherson KANSAS

SEC.	TWP.	R.
9	18	1 W

WELL NO. # 2 Stein FARM

COMPANY

CONTRACTOR Bennett & Roberts

Co. tools
Paden Pool


_____ Ft. from N. Line

330 _____ Ft. from S. Line

1325 _____ Ft. from E. Line

_____ Ft. from W. Line

C S $\frac{1}{2}$ S $\frac{1}{2}$ SE

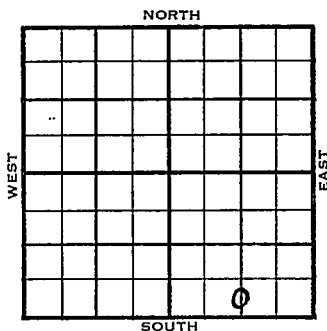

	ELEVATION	REPORT
1955	1415'	

1/12 Spud 1-9-55
8" @ 173 WOG

1/19 Spud 1-9-55
D & A
TD 2809'
8" @ 173'
Lans 2180', Cong 2744' Miss 2778'
TD 2809'
D & A

ABANDONED

County McPherson State Kansas

Sec. 9 (Blk. 18) (Sur. 1W) (Twp.) (Rge.) Map No.

Operator Bennett & Roberts

Well No. 2 Farm Stein

Elev. 1415 Location C S $\frac{1}{2}$ S $\frac{1}{2}$ SE

330 Ft. From S Line SE

1325 Ft. From E Line Quarter

1st. Report

Completion JAN 1 9 1955

Remarks Paden Pool

Co. tools

Spudding Date 1-9-55

Drlg. Data D & A TD 2809

8" @ 173 Lans. 2180 Cong. 2744

Miss. 2778 TD 2809

D & A

FABEN GILSTRAP