

DX 78-1


McPherson

KANSAS

Section 9 Township 18 Range 1W

Well No. #3 Stein

Company Glickman Oil

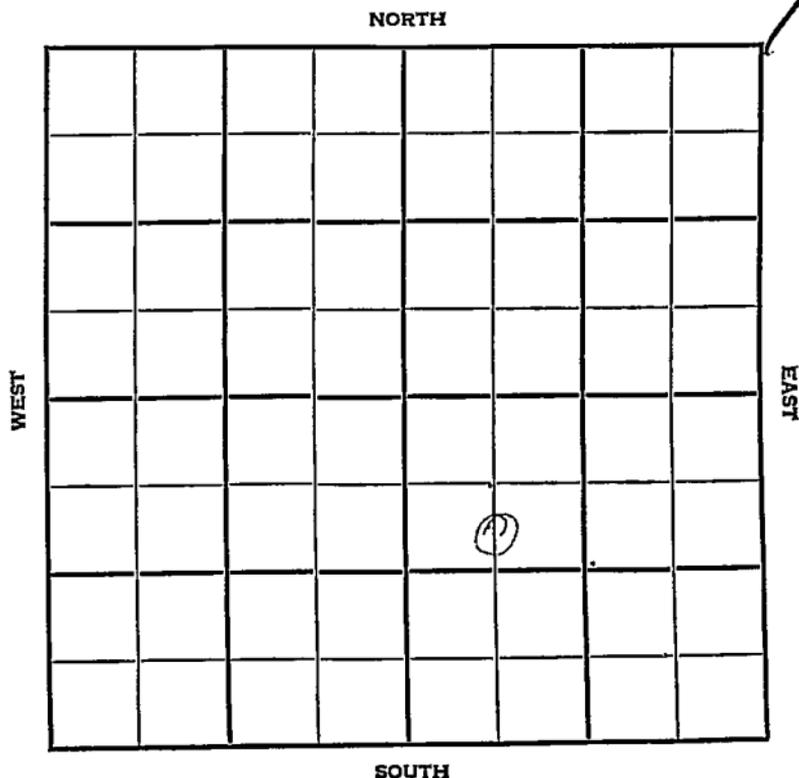

County McPherson Elev. _____
 Sec. 9 Twp. 18 Rgs. 1W
 Company Glickman Oil
 Farm Name Stein No. 3

TOPS	DEPTH	LOG	DATUM	Loc. in Sec.
Anh.				C S $\frac{1}{2}$ NW SE
Tp.				
H.				
Tr.				
Dg.				
Bl.				
L.				Geol. _____
K.C.				Contr. _____
B.K.C.				
Ce.				Renfro
C.				
M.				Pool
M.				Paden
K.				
Mz.				
Me.				
V.				
S.				
S.				
A.				
R.				
Pe.				
G.				
T.D.				

FIRST REPORT
 JAN 9 '57

Date Comm. 1-7-57
8" @ 161 drlg. 545

~~Handwritten mark~~

County McPherson Elev. 122-
 Sec. 9 Twp. 18 Rge. 1W
 Company Glickman Oil
 Farm Name Stein No. 3

TOPS	DEPTH	LOG	DATUM	Loc. in Sec.
Anh.				C S $\frac{1}{2}$ NW SE
Tr.				
H.				
Tr.				
Dg.				Geol.
Bl.				
L.	2195			Contr
K.C.				
BXC.				Renfwo
Ce.				
C.	2782	3782		Pool
M.				
K.				Paden
Mz.				
Mo.				<div style="border: 1px solid black; padding: 5px; text-align: center;"> ABANDONED JAN 30 '57 </div>
V.				
S.				
S.				
A.				
R.				
PE.				
G.				
TR	2857	2853		

Date Comm. 1-7-57
8" @ 161 orlg. 545
 JAN 30 '57

D & A (~~STEIN~~) ~~STEIN~~