


Form 51-5M-2-29-34703

Map No. **KANSAS** Sec. 32 Twp. 32 R. 5^E

Well No. 1-Pierce Farm

Schman et al Company

NORTH

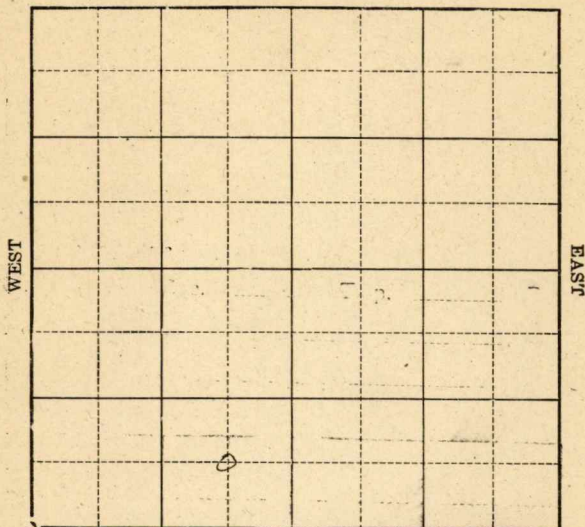

SOUTH

Location _____
Drilling Remarks _____

Rig Up _____
Drilling Remarks _____

RECORD

Cased _____ in. _____ ft.
Sand _____
Gas _____
Oil _____
Total Depth _____

PRODUCTION

1st 24 hrs. Nat. _____
1st 24 hrs. after shot _____
Gas _____ cu. ft.
Dry Hole _____
Abandoned _____


Cowley

Map No. **KANSAS** Sec. 32 Twp. 32 R. 5^E

Well No. 1- Pierce Farm

Lehman et al Company

NORTH

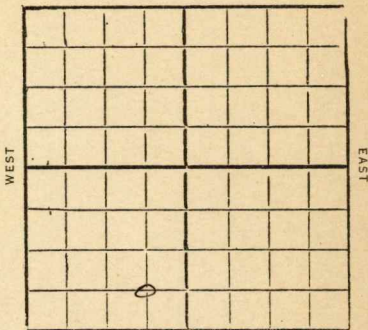

Ft. from N. Line

660 Ft. from S. Line

660 Ft. from E. Line

Ft. from W. Line

1931

SOUTH

Date

REPORT

7/29

Sand 638-646

T.D. 653

*1/4 H Gas
Comp.*

2 **KANSAS** Sec. *Cowley* 32 Twp. 32 R. 5^E

Well No. 1 *Pierce*
Lehman et al Company

Contractor

**FIRST REPORTS
 and
 COMPLETE**

SECTION PLAT

	0		

.....Ft. from N. Line

660.....Ft. from S. Line

660.....Ft. from E. Line

.....Ft. from W. Line

Location.....

Rig up.....

Drilling and Remarks:

RECORD

Cased.....in.,ft.

Sand *638-646*

Gas.....

Oil.....

Total Depth *653*

PRODUCTION

1st 24 hrs. Nat.....

1st 24 hrs. after shot.....

Gas *14 M*.....Cu. Ft.

Dry Hole.....

Abandoned.....

Date

JUL 29 1931

192.....

CHAS. L. SHERWOOD

Scout