


County Cowley Map No. KANSAS Sec. 32 Twp. 32 R. 5E

Well No. 1-5 Pierce Farm

Ben Mallory Company

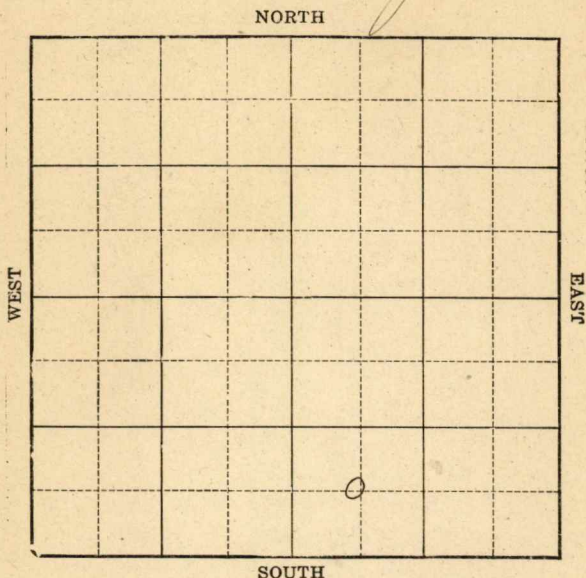

Location _____
Drilling Remarks _____

Rig Up _____
Drilling Remarks _____

RECORD

Cased _____ in. _____ ft.
Sand _____
Gas _____
Oil _____
Total Depth _____


PRODUCTION

1st 24 hrs. Nat. _____
1st 24 hrs. after shot _____
Gas _____ cu. ft.
Dry Hole _____
Abandoned _____

Map No. **KANSAS** Sec. 32 Twp. 32 R. 5^E

Well No. 1- Purice Farm
Ben Brallup Company

NORTH

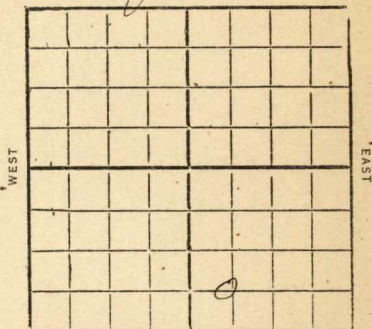

 Ft. from N. Line

660 Ft. from S. Line

 Ft. from E. Line

660 Ft. from W. Line

1931

SOUTH

Date

REPORT

6/24 Spdg 140'
7/1 Land 630-640
TD. 650
150,000 cu ft gas
Comp.

2
Map No. **KANSAS** Sec. *32* Twp. *32* R. *5* ^E

Well No. *1*
Bew *Pierce* *Gallapp* Company

Contractor

COMPLETE

SECTION PLAT

		0	

.....Ft. from N. Line

660Ft. from S. Line

.....Ft. from E. Line

660Ft. from W. Line

Location.....

Rig up.....

Drilling and Remarks:

RECORD

Cased.....in.,ft.

Sand *630-640*

Gas.....

Oil.....

Total Depth *650*

PRODUCTION

1st 24 hrs. Nat.....

1st 24 hrs. after shot.....

Gas *150,000* Cu. Ft.

Dry Hole.....

Abandoned.....

Date

JUL 1 1931

CHAS. L. SHERWOOD

192.....

Scout

Map No. **KANSAS** Sec. *Cowley 32* Twp. *32* R. *5* ^E
 Well No. *1* *Pierce*

Bew *Grallapp* Company

Contractor

FIRST REPORTS

SECTION PLAT

Ft. from N. Line

660 Ft. from S. Line

Ft. from E. Line

660 Ft. from W. Line

		0	

Location

Rig up *140'*

Drilling and Remarks:

RECORD

Cased.....in.,ft.

Sand.....

Gas.....

Oil.....

Total Depth.....

PRODUCTION

1st 24 hrs. Nat.....

1st 24 hrs. after shot.....

Gas.....Cu. Ft.

Dry Hole.....

Abandoned.....

Date

JUN 2 4 1931

192

CHAS. L. SHERWOOD

Scout