


Cowley KANSAS

DX 78-1

Section 32 Township 32 Range 5E

Well No. 1 Winslow

Company Wakefield

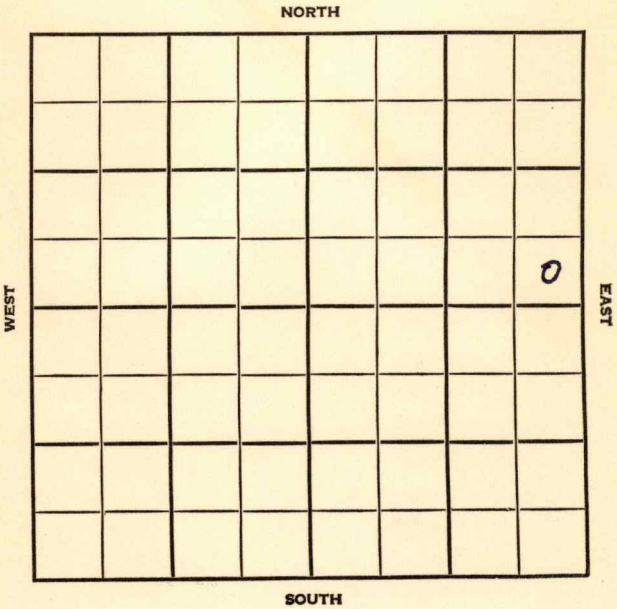

Cowley KANSAS


SEC. 32 TWP. 32 R. 5E ✓

WELL NO. 1 Winslow FARM

COMPANY Wakefield

CONTRACTOR

Ft. from N. Line  
330 Ft. from S. Line  
330 Ft. from E. Line  
Ft. from W. Line

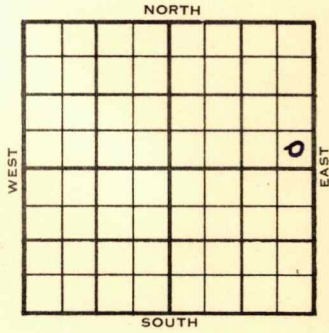

SE SE NE

1954 ELEVATION 1224' REPORT

7/21  
7/28

Location  
D&A - TD 3089'  
Stal. 1882', Layton 2340', KC 2503',  
Oswego 2695', Miss 3066'  
TD 3089'  
D&A

**ABANDONED**



