


Cowley

Map No. **KANSAS** Sec. 36 Twp. 32 R. 5

Well No. 1 - Feaster Farm
Empire-Marland Twin States Company

330 Ft. from N. Line
 _____ Ft. from S. Line
 _____ Ft. from E. Line
330 Ft. from W. Line

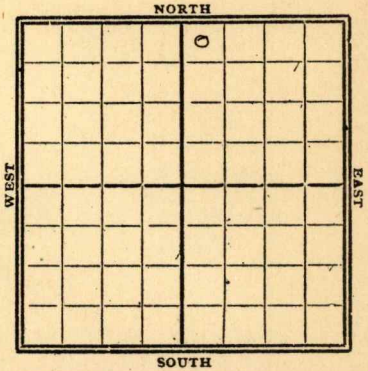

1928

Date	REPORT
10/3	Bldg Rig
10/10	
10/17	Spudding
10/24	Drilg 590'
10/31	" 1445'
11/7	" 1650
11/14	U/R 10" - 1750'
11/21	10" at 1839 - Drilg 1890'
11/28	Drilg 2265'
12/5	" 2485'
12/12	Chat 3067-93'
	show oil 3090 Drilg 3097'
12/19	Top line 3092'
	1 st break 3119-20'
	drilg 3165 - good show
12/26	" 3245'
1929	
1/2	Base line 3474'
	Top silc line 3529'
	show oil 3530' - HFW
	HFW 3546 P.B. to 3145'
1/9	P.B. to 3528' - Testing

1/16 - T.B. to 3185'

Pumped 39 bbls oil
10 " water

Testing

1/23 - shot 20 gts 3110-15'

Spig out

1/30 - chat 3067-93'

small show oil 3090'

Top line 3092'

1st break 3119-20'

B.L. 3474'

Top Silc. 3529'

show oil 3530'

T.D. 3546' - HFW

Abandoned

Cowley

Map No. **KANSAS** Sec. *36* Twp. *37* R. *5*

Well No. *1 Feaster*

Empire-Norfolk & Twin States Company

Contractor

COMPLETE

SECTION PLAT

330 Ft. from N. Line
Ft. from S. Line
Ft. from E. Line
330 Ft. from W. Line

		0	

ABANDONED

Location.....

Rig up.....

Drilling and Remarks:

*Chat 3067-3093' Small
show air 3090'
Top line 3092'
1st break 3119.20'
D.L. 3474' Top Silc
3529' show air 3530'
D9C*

RECORD

Cased.....in.,ft.

Sand.....

Gas.....

Oil.....

Total Depth *3546 HFW*

PRODUCTION

1st 24 hrs. Nat.....

1st 24 hrs. after shot.....

Gas.....Cu. Ft.

Dry Hole

Abandoned

Date

JAN 30 1929

CHAS. L. SHERWOOD

192

Scout

Cowley

K2 KANSAS

MAP NO. _____ SEC. 36 TWP. 32 R. 5

WELL NO. 1 Feaster

Empire-Marland-Twin States COMPANY

CONTRACTOR

FIRST REPORTS

SECTION PLAT

330

FT. FROM N. LINE

FT. FROM S. LINE

FT. FROM E. LINE

330

FT. FROM W. LINE

		0	

LOCATION _____

RIG UP _____

DRILLING AND REMARKS:

Blow big

RECORD

CASED _____ IN. _____ FT.

SAND _____

GAS _____

OIL _____

TOTAL DEPTH _____

PRODUCTION

1ST 24 HRS. NAT. _____

1ST 24 HRS. AFTER SHOT _____

GAS _____ CU. FT.

DRY HOLE _____

ABANDONED _____

DATE

OCT 3 1928

CHAS. L. SHERWOOD

192

SCOUT