

STATE CORPORATION COMMISSION OF KANSAS  
OIL & GAS CONSERVATION DIVISION  
WELL COMPLETION OR RECOMPLETION FORM  
ACO-1 WELL HISTORY  
DESCRIPTION OF WELL AND LEASE

Operator: License # 4767  
Name Ritchie Exploration, Inc.  
Address 125 N. Market, Suite 1000  
Wichita, KS 67202  
City/State/Zip

Purchaser N/A

Operator Contact Person Rocky Milford  
Phone 316-267-4375

Contractor: License # 6033  
Name Murfin Drilling Company

Wellsite Geologist Rocky Milford  
Phone 316-267-4375

Designate Type of Completion  
 New Well  Re-Entry  Workover  
 Oil  SWD  Temp Abd  
 Gas  Inj  Delayed Comp.  
 Dry  Other (Core, Water Supply etc.)

If OWWO: old well info as follows:  
Operator  
Well Name  
Comp. Date Old Total Depth

WELL HISTORY

Drilling Method:  
 Mud Rotary  Air Rotary  Cable  
10-31-87 11-7-87 11/08/87  
Spud Date Date Reached TD Completion Date  
4395' N/A  
Total Depth PBTD 8-5/8" @ 305'  
Amount of Surface Pipe Set and Cemented at...feet  
Multiple Stage Cementing Collar Used? Yes  No  
If yes, show depth set...feet  
If alternate 2 completion, cement circulated from...feet depth to...w/...SX cmt  
Cement Company Name  
Invoice #

API NO. 15-063-21,145

County Gove

N/2 NW SW Sec. 1 Twp. 15S Rge. 28 East West

2310 Ft North from Southeast Corner of Section  
4620 Ft West from Southeast Corner of Section

(Note: Locate well in section plat below)


Lease Name Case Trust Well # 1

Field Name

Producing Formation N/A

Elevation: Ground 2513' KB 2518'

Section Plat

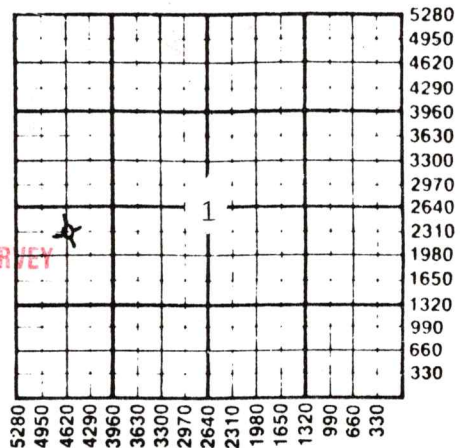

WATER SUPPLY INFORMATION

Disposition of Produced Water: Disposal  
Docket # N/A Repressuring

Questions on this portion of the ACO-1 call:

Water Resources Board (913) 296-3717

Source of Water: Hauled.  
Division of Water Resources Permit #

Groundwater...Ft North from Southeast Corner (Well) ...Ft West from Southeast Corner of Sec Twp Rge East West

Surface Water...Ft North from Southeast Corner (Stream, pond etc.)...Ft West from Southeast Corner Sec Twp Rge East West

Other (explain) (purchased from city, R.W.D. #)

INSTRUCTIONS: This form shall be completed in triplicate and filed with the Kansas Corporation Commission, 200 Colorado Derby Building, Wichita, Kansas 67202, within 120 days of the spud date of any well. Rule 82-3-130, 82-3-107 and 82-3-106 apply.

Information on side two of this form will be held confidential for a period of 12 months if requested in writing and submitted with the form. See rule 82-3-107 for confidentiality in excess of 12 months. One copy of all wireline logs and drillers time log shall be attached with this form. Submit CP-4 form with all plugged wells. Submit CP-111 form with all temporarily abandoned wells.

**SIDE TWO**

Operator Name ..... Ritchie Exploration, Inc. ..... Lease Name..... Case Trust ..... Well #..... 1

Sec..... 1 ..... Twp..... 15S ..... Rge..... 28 .....  East  
 West ..... County..... Gove .....

**WELL LOG**

**INSTRUCTIONS: Show important tops and base of formations penetrated. Detail all cores. Report all drill stem tests giving interval tested, time tool open and closed, flowing and shut-in pressures, whether shut-in pressure reached static level, hydrostatic pressures, bottom hole temperature, fluid recovery, and flow rates if gas to surface during test. Attach extra sheet if more space is needed. Attach copy of log.**

Drill Stem Tests Taken  Yes  No  
 Samples Sent to Geological Survey  Yes  No  
 Cores Taken  Yes  No

**Formation Description**  
 Log  Sample

DST #1 from 3887' to 3955' (Lansing "I" & "J" zones). Recovered 50' of mud, no show of oil.  
 IFP:43-54#/45"; ISIP:1157#/45";  
 FFP:54-54#/45"; FSIP:1114#/45".

Name	Top	Bottom
Anhydrite	1958' (+ 560)	
B/Anhydrite	1994' (+ 524)	
Heebner	3667' (-1149)	
Toronto	3688' (-1170)	
Lansing	3706' (-1188)	
Stark	3952' (-1434)	
B/KC	4018' (-1500)	
Marmaton	4054' (-1536)	
Pawnee	4123' (-1605)	
Myrick Sta.	4169' (-1651)	
Ft. Scott	4206' (-1688)	
Cherokee	4233' (-1715)	
Rew. Miss.	4309' (-1791)	
Miss. Dolo.	4354' (-1836)	
LTD	4395' (-1877)	

<p align="center"><b>CASING RECORD</b> <input checked="" type="checkbox"/> New <input type="checkbox"/> Used</p> <p align="center">Report all strings set-conductor, surface, intermediate, production, etc.</p>							
Purpose of String	Size Hole Drilled	Size Casing Set (In O.D.)	Weight Lbs/Ft.	Setting Depth	Type of Cement	#Sacks Used	Type and Percent Additives
Surface	12 1/2"	8-5/8"	24#	305'	60-40 Poz	185	2% gel, 3% cc
<b>PERFORATION RECORD</b>				<b>Acid, Fracture, Shot, Cement Squeeze Record</b>			
Shots Per Foot	Specify Footage of Each Interval Perforated			Amount and Kind of Material Used			Depth
<b>TUBING RECORD</b>				Liner Run <input type="checkbox"/> Yes <input type="checkbox"/> No			
Date of First Production	Producing Method						
<input type="checkbox"/> Flowing <input type="checkbox"/> Pumping <input type="checkbox"/> Gas Lift <input type="checkbox"/> Other (explain).....							