

Cowley

**KANSAS**

SECTION 1 TOWNSHIP 32 RANGE 6E

WELL NO. #5 Brooks

COMPANY Texas Company

NORTH

						0	

WEST

EAST

SOUTH

Cowley

KANSAS

SEC. 1	TWP. 32	R. 6E
-----------	------------	----------

WELL NO.

#5 Brooks

FARM

COMPANY

Texas Company

CONTRACTOR

Estes


\_\_\_\_\_ Ft. from N. Line

\_\_\_\_\_ Ft. from S. Line

\_\_\_\_\_ Ft. from E. Line

\_\_\_\_\_ Ft. from W. Line

SW NE SE

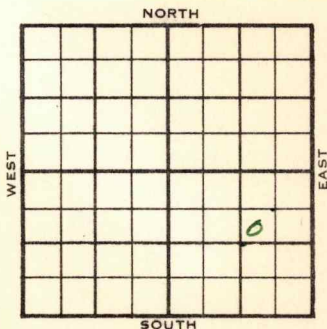

1956

ELEVATION  
1314

REPORT

5-9  
6-13

Location

Comm. 5-10-56

10 3/4" @124 w/125

7" @ 2204 w/175

CO 2173, 16/ 2112-16, 16/2122-26

5 go / 54 gw in 1 1/2 hr

fran F/w w6 bo / ~~126~~ 162 bw in 10 hrs

F/2 5 bo / 34 bw 3 hrs.

P/ 28 bo 262 bw in 24 hrs.

pumping 42 bo, 263 bw, 24 hrs./

gas 2410

Stall 1711', L. 1848',

Log: Stall 1719', L. 1845',

K.C. 2062', Lay 2112-26',

TD 2205'

**COMPLETED**

County Cowley Elev. \_\_\_\_\_  
 Sec. 1 Twp. 32 Rge. 6E  
 Company Texas Company  
 Farm Name Brooks No. 5

TOPS	DEPTH	LOG	DATUM	Loc. in Sec.
Anh.				SW NE SE
Tp.				
H.				
Tr.				
Dg.				
Bl.				
L.				Geol. _____
K.C.				Contr. _____
B.K.C.				
Ce.				
C.				
M.				Pool _____
Mz.				Estes
Mq.				
V.				
S.				
S.				
A.				
R.				
Pe.				
G.				
T.D.				

FIRST REPORT  
 MAY 9 1956

Date Comm. \_\_\_\_\_  
 Location Brooks

MAY 14 1956  
 R. S.

County Cowley Elev. 1314  
 Sec. 1 Twp. 32 Rge. 6E  
 Company Texas Company  
 Farm Name Brooks No. 5

Co.

TOPS	DEPTH	LOG	DATUM
Anh			
Top <u>57811</u>	<u>1711</u>	<u>1717</u>	
H.			
Tr.			
Dg.			
Bl.			
L.	<u>1848</u>	<u>1844</u>	
K.C.		<u>2062</u>	
B.K.C. <u>lay</u>		<u>211'</u>	
Ce.			
C.			
M.			
M.			
K.			
Mz.			
Ma.			
V.			
S.			
S.			
A.			
R.			
Pe.			
G.			
TD.	<u>2205</u>		

Loc. in Sec. SW NE SE  
 Geol. \_\_\_\_\_  
 Contr. \_\_\_\_\_  
 Pool \_\_\_\_\_  
Estes  
 COMPLETE  
 JUN 13 '56

Sec.

No.

Sec.

T.

R.

Date Comm.

Location MAY 16 '56 5-10-56 10 3/4  
124/125 @ 2000 MAY 23 '56 7" @ 2204  
1175 CO 2173 16/2112-16  
16/2122-26 @ 5:60 + 54  
GW in 1 1/2 hrs Frac Flw  
26 BO + 162 BW in 10 hrs MAY 29 '56  
Flw 5 BO + 34 BW 3 hrs JUN 6 '56  
P 27 BO 262 BW - 29 hrs.  
JUN 13 '56 Pump 42 BO 263 BW - 24 hrs / 6 241°  
lay 2112-26