

STATE CORPORATION COMMISSION OF KANSAS
OIL & GAS CONSERVATION DIVISION
WELL COMPLETION OR RECOMPLETION FORM
ACO-1 WELL HISTORY
DESCRIPTION OF WELL AND LEASE

Operator: License # 9067, 5363 & 6113
Name Damar Resources, Inc. BEREXCO Inc
and Landmark Oil Exploration, Inc.
Address
P. O. Box 70
City/State/Zip Hays, KS 67601

Purchaser.....

Operator Contact Person Dan Schippers
Phone (913) 625-0020

Contractor: License # 5147
Name BEREDCO INC.

Wellsite Geologist Ken Wallace
Phone (316) 265-9444

Designate Type of Completion

New Well Re-Entry Workover
 Oil SWD Temp Abd
 Gas Inj Delayed Comp.
 Dry Other (Core, Water Supply etc.)

If **OWWO**: old well info as follows:

Operator
Well Name
Comp. Date Old Total Depth.....

WELL HISTORY

Drilling Method:

Mud Rotary Air Rotary Cable

..11-06-87.. ..11-08-87.. ..11-08-87..
Spud Date Date Reached TD Completion Date

..2594 (R.T.D.) ..
Total Depth PBTD

Amount of Surface Pipe Set and Cemented at 304 feet
Multiple Stage Cementing Collar Used? Yes No
If yes, show depth set.....feet
If alternate 2 completion, cement circulated
from.....feet depth to.....w/.....SX cmt
Cement Company Name
Invoice #

API NO. 15-063-21-162
County Gove
..NE..NE..SW.. Sec. 10.. Twp. 15S.. Rge. 28.. East
 West

..2310..... Ft North from Southeast Corner of Section
..2970..... Ft West from Southeast Corner of Section
(Note: Locate well in section plat below)


Lease Name Roberts/Ladd 'B' Well # 1

Field Name Wildcat

Producing Formation.....

Elevation: Ground 2478 KB 2483

Section Plat

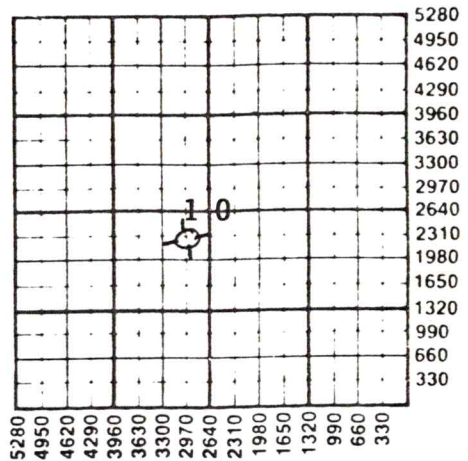

RECEIVED
STATE CORPORATION COMMISSION
DEC 2 1987
CONSERVATION DIVISION
Wichita, Kansas

WATER SUPPLY INFORMATION

Disposition of Produced Water: Disposal
Docket # Repressuring

Questions on this portion of the ACO-1 call:
Water Resources Board (913) 296-3717

Source of Water:
Division of Water Resources Permit #.....

Groundwater.....Ft North from Southeast Corner
(Well)Ft West from Southeast Corner of
Sec Twp Rge East West

Surface Water.....Ft North from Southeast Corner
(Stream pond etc).....Ft West from Southeast Corner
NE/4 SW/4 Sec 10 Twp 15S Rge 28 East West

Other (explain).....
(purchased from city, R.W.D. #)

INSTRUCTIONS: This form shall be completed in triplicate and filed with the Kansas Corporation Commission, 200 Colorado Derby Building, Wichita, Kansas 67202, within 120 days of the spud date of any well. Rule 82-3-130, 82-3-107 and 82-3-106 apply. Information on side two of this form will be held confidential for a period of 12 months if requested in writing and submitted with the form. See rule 82-3-107 for confidentiality in excess of 12 months. One copy of all wireline logs and drillers time log shall be attached with this form. Submit CP-4 form with all plugged wells. Submit CP-111 form with all temporarily abandoned wells.

Handwritten initials

DaMar Resources, Inc., BEREXCO Inc. and

Operator Name Landmark Okl. Exploration, Inc. Lease Name Roberts/Ladd 'B' Well # 1

Sec. 10 Twp. 15S Rge. 28 East West County Gove

WELL LOG

INSTRUCTIONS: Show important tops and base of formations penetrated. Detail all cores. Report all drill stem tests giving interval tested, time tool open and closed, flowing and shut-in pressures, whether shut-in pressure reached static level, hydrostatic pressures, bottom hole temperature, fluid recovery, and flow rates if gas to surface during test. Attach extra sheet if more space is needed. Attach copy of log.

Drill Stem Tests Taken [] Yes [X] No
Samples Sent to Geological Survey [] Yes [X] No
Cores Taken [] Yes [X] No

Formation Description [X] Log [] Sample

Table with 3 columns: Name, Top, Bottom. Rows include Anhydrite (1917 to +566), B. Anhydrite (1949 to +534), R.T.D. (2594 to -111), L.T.D. (2000 to +483).

CASING RECORD [] New [X] Used

Report all strings set-conductor, surface, intermediate, production, etc.

Table with 8 columns: Purpose of String, Size Hole Drilled, Size Casing Set (in O.D.), Weight Lbs/Ft., Setting Depth, Type of Cement, #Sacks Used, Type and Percent Additives. Row 1: Surface, 12 1/4", 8 5/8", 25#, 304', 60/40 pps, 180, 2% gel and 3% c.c.

PERFORATION RECORD

Acid, Fracture, Shot, Cement Squeeze Record

Table with 4 columns: Shots Per Foot, Specify Footage of Each Interval Perforated, (Amount and Kind of Material Used), Depth. Multiple rows for data entry.

TUBING RECORD Size Set At Packer at Liner Run [] Yes [] No

Date of First Production Producing Method [] Flowing [] Pumping [] Gas Lift [] Other (explain)