


KANSAS Ellsworth

Form 51-5M-7-40-Palace

Section 27 Township 16 Range 10-W


Well No. #3 Stoltenberg "A"

Company Atlantic

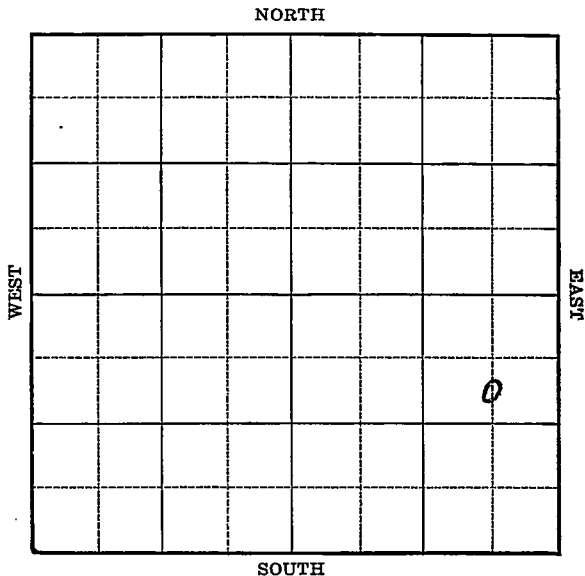

Well No. #3 Stoltenberg "A" Farm
Atlantic Company

Elev. 1839

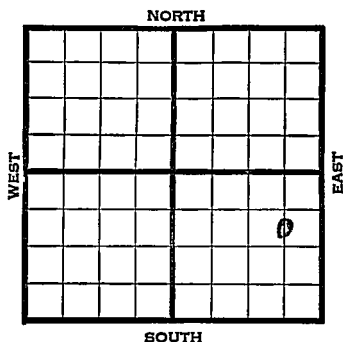[illegible]

Map No. 55 Sec. 27 Twp. 16 R. 10WWell No. 3 Stoltenberg "A"Atlantic

Company

Contractor

FIRST REPORT

SECTION PLAT

990 C S L NE SE
Ft. from N. Line

Ft. from S. Line

660 Ft. from E. Line

Ft. from W. Line

STOLTENBERG POOL

Location _____

Rig up _____

Drilling and Remarks: .

8" - 380
WOC

RECORD

Cased _____ in., _____ ft.

Sand _____

Gas _____

Oil _____

Total Depth _____

PRODUCTION

1st 24 hrs. Nat. _____

1st 24 hrs. after shot _____

Gas _____ Cu. Ft.

Dry Hole _____

Abandoned _____

Date

SEP 11 1940 19

S. J. LEWIS Scout

Map No. 55 Sec. 27 Twp. 16 R. 10WWell No. 3 Stoltenberg "A"Atlantic

Company

Contractor

COMPLETED

C S L N E S E

990 Ft. from N. Line Ft. from S. Line660 Ft. from E. Line Ft. from W. Line

STOLTENBERG POOL

SECTION PLAT

			o

Location Rig up

Drilling and Remarks:

*Cor 83289 1/2 corrected**5" C 8289 1/2**Depth P.D. 7492**Max 3000***RECORD**Cased in., ft.Sand Gas Oil Total Depth 3291**PRODUCTION**1st 24 hrs. Nat. 1st 24 hrs. after shot Gas Cu. Ft.Dry Hole Abandoned

Date

OCT 2 1940 19

S. J. LEWIS Scout