

KANSAS

Form 51—5M—7-40—Palace


Ellsworth

Section 27 Township 16 Range 10-W

Well No. #4 Stoltenberg "A"


Company Atlantic Production et al

NORTH Stoltenberg Pool

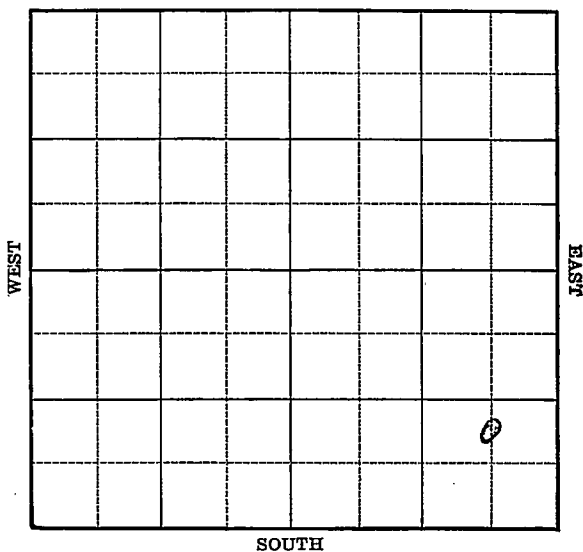

Sec. 27 Twp. 16 R. 10-WWell No. #4 Stoltenberg "A" FarmAtlantic Production et al Company
(Stoltenberg) Ft. from N. Line990 Ft. from S. Line660 Ft. from E. Line Ft. from W. Line

Elev. 1838

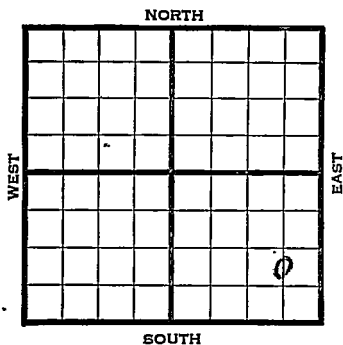

1940

REPORT

11/13

8" - 371'

Drlg. 1408'

11/21

Drlg. 3180'

11/27

Lans. 2980' Arb. 3289'

5" - 3289' T.D. 3293'

Swab 110 bbls. oil 2 hrs.

12/4

Arb. 3829'

5" - 3829'

T.D. 3301'

1000 acid.

Depthograph potential 2020 bbls.

45.2 Gravity

COMPLETED

Map No. 55 Sec. 27 Twp. 16 R. 10WWell No. 4 Stoltenberg "A"Atlantic Production et al
Company

Contractor

FIRST REPORT

C N L S E S E

 Ft. from N. Line990 Ft. from S. Line660 Ft. from E. Line Ft. from W. Line

STOLTENBERG POOL

SECTION PLAT

			o

Location Rig up

Drilling and Remarks:

8" - 371

Drlg. 1408

RECORDCased in., ft.Sand Gas Oil Total Depth **PRODUCTION**1st 24 hrs. Nat. 1st 24 hrs. after shot Gas Cu. Ft.Dry Hole Abandoned

Date

NOV 13 1940₁₉S. J. LEWIS Scout

Map No. 55 Sec. 27 Twp. 16 R. 10WWell No. 4 Stoltzenberg "A"Atlantic Production et al
Company

Contractor

COMPLETED

C N L SE SE

Ft. from N. Line

990 Ft. from S. Line660 Ft. from E. Line

Ft. from W. Line

STOLTZENBERG POOL

SECTION PLAT

			o

Location

Rig up

Drilling and Remarks:

Cr & 3829
5" @ 3829
1000 each
Depth to 2020
452 gr

RECORD

Cased _____ in., _____ ft.

Sand _____

Gas _____

Oil _____

Total Depth 3801

PRODUCTION

1st 24 hrs. Nat. _____

1st 24 hrs. after shot _____

Gas _____ Cu. Ft.

Dry Hole _____

Abandoned _____

Date

DEC 4 1940

S. J. LEWIS

Scout