

Ellsworth


KANSAS

Form 51-5M-7-39-Palace

Section 27 Township 16 Range 10-W

Well No. #1 Stoltenberg "D"

Company Stanolind - Gulf

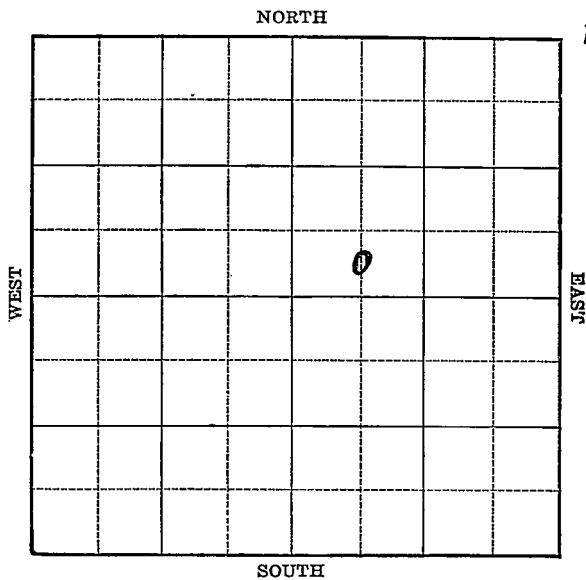

KANSAS


Ellsworth

Sec. 27 Twp. 16 R. 10-WWell No. #1 Stoltenberg "D" FarmStanolind - Gulf Company

(Stoltenberg)

 Ft. from N. Line330 Ft. from S. Line Ft. from E. Line660 Ft. from W. Line

Elev. 1831

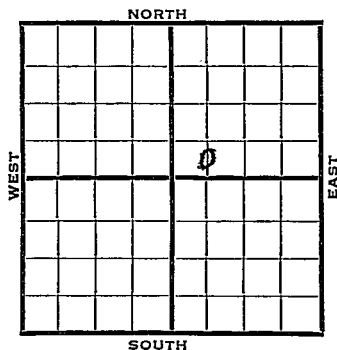

1940	REPORT
4/3	Location
4/12	Drlg. 2330'
4/18	R.U.R.
4/25	8" - 251' Anhy 585'
	Drlg. 1881'
5/2	Lansing 2950' Arb. 3279'
	S.O. 3281-85' T.D. 5 $\frac{1}{2}$ " - 3279'
	WOC.
5/9	Swab 56 bbls. 2 hours 1200'
	from top.
5/15	Arb. 3279'
	5" - 3279'.
	T.D. 3288'
	1000 acid.
	Depthograph potential 18,336
	Maximum 3000 bbls.
	COMPLETED

Map No. 53 Sec. 27 Twp. 16 R. 10WWell No. 1 Stoltenberg "D"Stanolind - Gulf

Company

Contractor

FIRST REPORT

C S L SW NE


Ft. from N. Line

330 Ft. from S. Line

Ft. from E. Line

660 Ft. from W. Line

SECTION PLAT

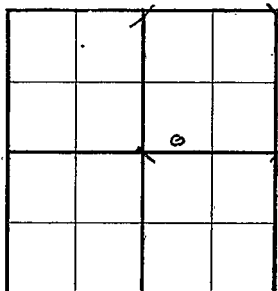

STOLTENBERG POOL

Location X

Rig up

Drilling and Remarks:

RECORD

Cased _____ in., _____ ft.

Sand _____

Gas _____

Oil _____

Total Depth _____

PRODUCTION

1st 24 hrs. Nat. _____

1st 24 hrs. after shot _____

Gas _____ Cu. Ft.

Dry Hole _____

Abandoned _____

Date

APR 3 1940

19

S. J. LEWIS Scout

Map No. 55 Sec. 27 Twp. 16 R. 10WWell No. 1 Stoltenberg "D"Stanolind - Gulf Company

Contractor

COMPLETED

C S L SW NE

 Ft. from N. Line330 Ft. from S. Line Ft. from E. Line660 Ft. from W. Line**SECTION PLAT**

STOLTENBERG POOLLocation Rig up

Drilling and Remarks:

*Ar 83279**5' @ 3279**1000 acid**Depthograph 28**18336.**Maximum 3000***RECORD**Cased in., ft.Sand Gas Oil Total Depth 3288**PRODUCTION**1st 24 hrs. Nat. 1st 24 hrs. after shot Gas Cu. Ft.Dry Hole Abandoned

Date

MAY 15 194019S. J. LEWIS Scout