

# KANSAS

Form 51-5M-7-39-Palace


Ellsworth

Section 27 Township 16 Range 10-W

Well No. #2 Stoltenberg "A"

Company Atlantic

NORTH Stoltenberg Pool

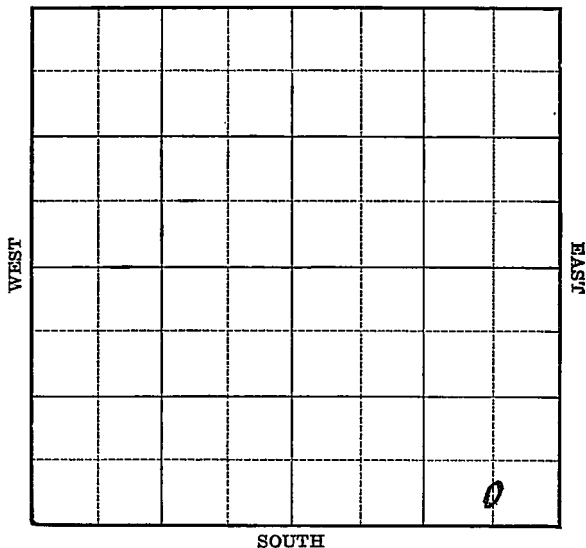

Sec. 27 Twp. 16 R. 10-W

Well No. #2 Stoltenberg "A" Farm

Atlantic Company

(Stoltenberg)


\_\_\_\_\_ Ft. from N. Line

330 Ft. from S. Line

660 Ft. from E. Line

\_\_\_\_\_ Ft. from W. Line

Elev. 1831

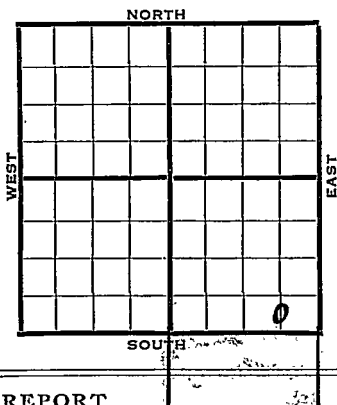

1940 REPORT

6/26 Location

7/3 8" - 366' WOC.

7/11 Lans. 2975' Drlg. 3125'

Running 6' lower on Lansing than Lauck #1 Meyer

NW/c 35 a 8800 bbl. Arbuckle well

7/18 Top Arbuckle 3284 5" 3284 T.D. 3290

Filled up 3100 feet oil in 18 hrs. (Tel)

Running 3' lower on Arbuckle than our #2

Matosh south offset

7/24 Arb. 3284'

5" - 3284'

T.D. 3290'

2000 acid.

Depthograph potential 32,000 bbls

Maximum 3000 bbls.

COMPLETED

Map No. 55 Sec. 27 Twp. 16 R. 10W

Well No. 2 Stoltenberg "A"

Atlantic

Company

Contractor

**FIRST REPORT**

**SECTION PLAT**

C S L SE SE

			o

         Ft. from N. Line

330 Ft. from S. Line

660 Ft. from E. Line

         Ft. from W. Line

**STOLTENBERG POOL**

Location X

Rig up         

Drilling and Remarks:

*Spec 1*

**RECORD**

Cased          in.,          ft.

Sand         

Gas         

Oil         

Total Depth         

**PRODUCTION**

1st 24 hrs. Nat.         

1st 24 hrs. after shot         

Gas          Cu. Ft.

Dry Hole         

Abandoned         

Date

JUN 26 1940 19

S. J. LEWIS Scout

Map No. \_\_\_\_\_ Sec. 27 Twp. 16 R. 10W

Well No. 2 Stoltenberg "A"

Atlantic

Company

Contractor

**COMPLETED**

**SECTION PLAT**

C S L SE SE


\_\_\_\_\_ Ft. from N. Line

330 Ft. from S. Line

660 Ft. from E. Line

\_\_\_\_\_ Ft. from W. Line

**STOLTENBERG POOL**

Location \_\_\_\_\_

**RECORD**

Cased \_\_\_\_\_ in., \_\_\_\_\_ ft.

Sand \_\_\_\_\_

Gas \_\_\_\_\_

Oil \_\_\_\_\_

Total Depth 3296

Rig up \_\_\_\_\_

Drilling and Remarks:

*Co 83284*

*5" 110 3284*

*2000 acid*

*Depthograph*

*32000*

*Mag 3000*

**PRODUCTION**

1st 24 hrs. Nat. \_\_\_\_\_

1st 24 hrs. after shot \_\_\_\_\_

Gas \_\_\_\_\_ Cu. Ft.

Dry Hole \_\_\_\_\_

Abandoned \_\_\_\_\_

Date

JUL 24 1940 19

S: J. LEWIS Scout