

KANSAS

Form 51—5M—7-40—Palace

Ellsworth

Section 27 Township 16 Range 10-W

Well No. #3 Stoltenberg "B"

Company Tom Palmer et al

NORTH Stoltenberg Pool

			0				

WEST

EAST

SOUTH

3

KANSAS


Ellsworth

Sec. 27 Twp. 16 R. 10WWell No. 3 Stoltenberg "B" FarmTom Palmer et al Company

(Stoltenberg Pool)

660 Ft. from N. Line Ft. from S. Line330 Ft. from E. Line Ft. from W. Line

Elev. 1823

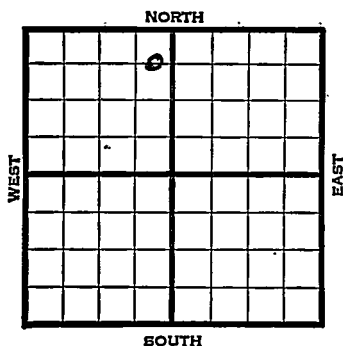

1940

REPORT

8/28

SD 2355 8" 197

9/5

Arb. 3286-88' T.D. 5" - 3286'

RUST.

9/11

Arb. 3286'

5" - 3286'

T.D. 3288'

Depthograph potential 3086 bbls.

Maximum 3000 bbls.

COMPLETED

KANSAS

Form 26-200 Bks.-1-40-Palace Ellsworth

Map No. _____ Sec. 27 Twp. 16 R. 10W

Well No. 3 Stoltenberg "B"

Tom Palmer et al _____ Company

Contractor _____

FIRST REPORT

C E L NE NW

660 _____ Ft. from N. Line

_____ Ft. from S. Line

330 _____ Ft. from E. Line

_____ Ft. from W. Line

STOLTENBERG POOL

SECTION PLAT

Location _____

Rig up _____

Drilling and Remarks:

8" - 197

2355' SD

RECORD

Cased _____ in., _____ ft.

Sand _____

Gas _____

Oil _____

Total Depth _____

PRODUCTION

1st 24 hrs. Nat. _____

1st 24 hrs. after shot _____

Gas _____ Cu. Ft.

Dry Hole _____

Abandoned _____

Date

AUG 28 1940 19

S. J. LEWIS Scout

