


Section 27 Township 16 Range 10WWell No. #4 Stoltenberg "B"Company Atlantic etal.

KANSAS

Ellsworth

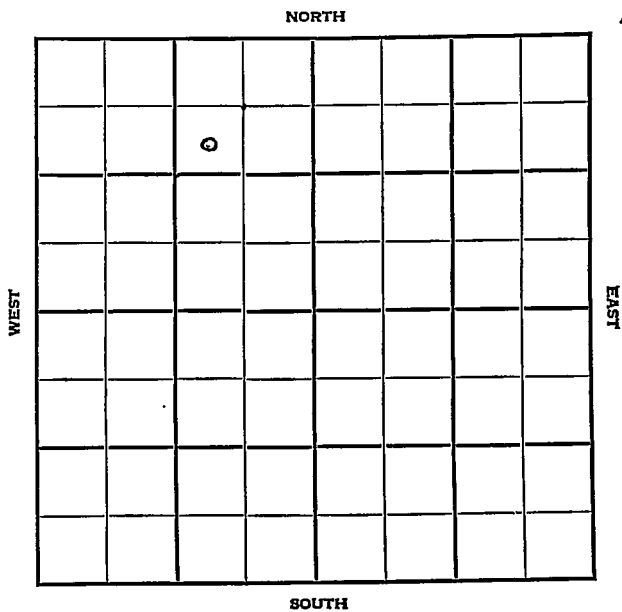

Sec. 27 Twp. 16 R. 10W

Well No. #4 Stoltenberg "B" Farm.

Atlantic et al Company

Stoltenberg Pool


990' Ft. from N. Line

 Ft. from S. Line

990' Ft. from E. Line

 Ft. from W. Line

SW NE NW

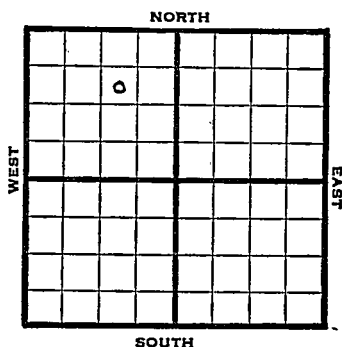

1948

Elev. 1833

REPORT

2/4 Location

2/11 RUR

2/18 8" @ 381'
Drlg 1365'

2/25 Drlg. 3265'

3/3 Lansing 2988'
Arbuckle 3293'
TD 3297'
5" @ 3295'
RUST

3/10 "

3/17 "

3/24 "

3/31 "

4/7 TD 3307½'
500 acid.

4/14 "

4/21 TD 3314'
31' 6" of 4" Perf liner

OVER

1948

4/28 Arbuckle 3293'
5" @ 3295'
Pump 27 oil & 1% W Pot.
Gr. 42°
TD 3314'

COMPLETED

Map No. _____ Sec. 27 Twp. 16 R. 10W

Well No. 4 Stoltenberg "B"

Atlantic etal. Company

FIRST REPORT Contractor

SW NE NW


SECTION PLAT

990 Ft. from N. Line

_____ Ft. from S. Line

990 Ft. from E. Line

_____ Ft. from W. Line

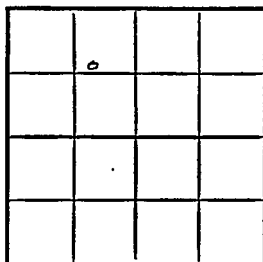

Ellsworth County

Location X

Rig up _____

Drilling and Remarks:

RECORD

Cased _____ in., _____ ft.

Sand _____

Gas _____

Oil _____

Total Depth _____

PRODUCTION

1st 24 hrs. Nat. _____

1st 24 hrs. after shot _____

Gas _____ Cu. Ft.

Dry Hole _____

Abandoned _____

Date

FEB 4 1948 19 _____ S. J. LEWIS Scout

Map No. 55 Sec. 27 Twp. 16 R. 10W

Well No. 4 Stoltenberg "B"

Atlantic etal. Company

COMPLETE

Contractor

SW NE NW


E. 1/2
SECTION PLAT

990 Ft. from N. Line

 Ft. from S. Line

990 Ft. from E. Line

 Ft. from W. Line

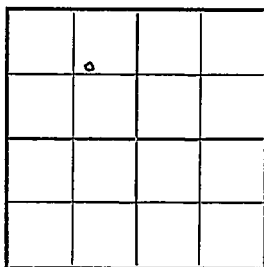

Ellsworth County

Location

Rig up

Drilling and Remarks:

Cor 13293

5' @ 3295

Prod 27 oil 1 1/2 W
OST

42 = 1/2

RECORD

Cased in., ft.

Sand

Gas

Oil

Total Depth 33 1/4

PRODUCTION

1st 24 hrs. Nat.

1st 24 hrs. after shot

Gas Cu. Ft.

Dry Hole

Abandoned

Date

APR 28 1948

19

S. J. LEWIS

Scout