

KANSAS

Form 51-5M-7-40-Palace


Ellsworth

Section 27 Township 16 Range 10-W

Well No. #4 Stoltenberg "D"

Company Stanolind et al

NORTH Stoltenberg Pool

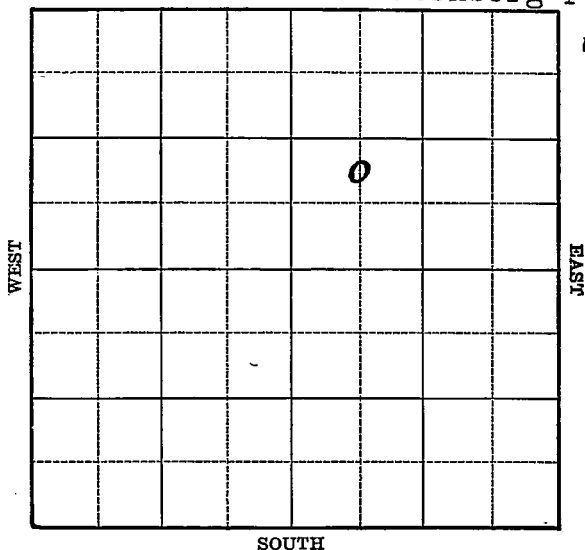

KANSAS


Ellsworth

Sec. 27 Twp. 16 R. 10-WWell No. #4 Stoltenberg "D" FarmStanolind et al Company

(Stoltenberg)

 Ft. from N. Line990 Ft. from S. Line Ft. from E. Line660 Ft. from W. Line

Elev. 1827

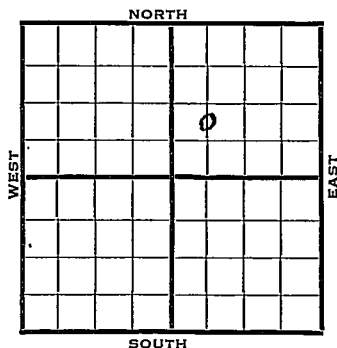

1940	REPORT
8/14	Location
8/22	"
8/29	8" - 260' WOC.
9/5	Anhy 615' Drlg. 29 05'
9/12	Arb. 3298' T.D. 3301'
	5" - 3299' RUST.
9/19	T.D. 3317' 2000 acid.
	Shot 20 qts. 3305-15'
	Fsg. swab.
9/26	T.D. 3319' 3 bailers water per
	hour. P.B. 3311'
10/2	Arb. 3298'
	5" - 3299'
	T.D. 3317'
	P.B. to 3311'
	Shot 20 qts. 3305-15'
	3500 acid.
	Potential 283 oil & 16 water on
	pump.
	COMPLETED

Map No. _____ Sec. 27 Twp. 16 R. 10WWell No. 4 Stoltenberg "D"Stanolind etal Company_____
Contractor

SECTION PLAT

		o	

C N L SW NE
Ft. from N. Line990
Ft. from S. Line_____
Ft. from E. Line660 Ft. from W. Line

STOLTENBERG POOL

Location X

Rig up _____

Drilling and Remarks:

RECORD

Cased _____ in., _____ ft.

Sand _____

Gas _____

Oil _____

Total Depth _____

PRODUCTION

1st 24 hrs. Nat. _____

1st 24 hrs. after shot. _____

Gas _____ Cu. Ft.

Dry Hole _____

Abandoned _____

Date

AUG 14 1940 19____S. J. LEWIS Scout

Map No. 55 Sec. 27 Twp. 16 R. 10WWell No. 4 Stoltenberg "D"Stanolind etal Company

Contractor

COMPLETED

C N L SW NE

Ft. from N. Line

990 Ft. from S. Line

Ft. from E. Line

660 Ft. from W. Line

STOLTENBERG POOL

SECTION PLAT

		o	

Location _____

Rig up _____

Drilling and Remarks:

*Ac 8.3298**5" @ 3299**P.B. 3311**209 to 3305-15.**3500 a cu ft**Pump. 283 oil*
16 1/4 P.B.

RECORD

Cased _____ in., _____ ft.

Sand _____

Gas _____

Oil _____

Total Depth 3312

PRODUCTION

1st 24 hrs. Nat. _____

1st 24 hrs. after shot _____

Gas _____ Cu. Ft.

Dry Hole _____

Abandoned _____

Date

OCT 2 1940 19 S. L. LEWIS Scout