

KANSAS

Form 51-5M-7-40-Palace

Ellsworth

Section 27 Township 16 Range 10-W

Well No. #3 Stoltenberg "E"

Company Atlantic et al


NORTH

Stoltenberg Pool

WEST

EAST

SOUTH

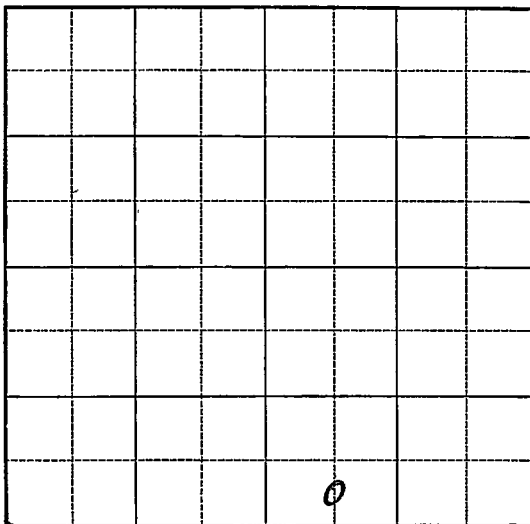

Sec. 27 Twp. 16 R. 10-W

Well No. #3 Stoltenberg "E" Farm

Atlantic et al Company


(Stoltenberg)

 Ft. from N. Line

330 Ft. from S. Line

 Ft. from E. Line

660 Ft. from W. Line

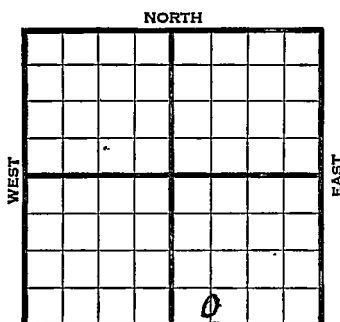

"OFFSET"

SOUTH

Matosh

1940	Elev. 1813	REPORT
10/2	Location	
10/10	Derrick.	
10/17	8" - 363' Anhy. 560'	
	Drlg. 2410'	
10/22	Dlg. 3050 Expect top Arbuckle this afternoon (Tel)	
10/24	Dlg. 3190 (Drilling report)	
10/24	Dlg. 3270 No Arbuckle yet (Tel)	
10/24	Top Arbuckle 3279	
	At 3283 cherty dolomite	
	Drilled to 3285 porous crystalline dolomite slight show oil	
	Core 3285-88 Recovered 2 $\frac{1}{2}$ ' porous dolomite spotted stain	
	Set 5 $\frac{1}{2}$ " 3280 Rust (Tel)	
Running	13' lower on Arbuckle than Atlantic #2 east offset a 52,000 bbl depthograph well	
Running	1' lower than Atlantic #2 C S/2 NW SE	
Sec. 27	completed for depthograph potential of 1456 bbls. (pumped only 15 bbls. per day)	
Running	16' lower than our #2 Matosh C N/2 NE	
NE Sec. 34	completed for depthograph potential of 3815 bbls. (VLF)	

OVER

1940

10/28--Top Arbuckle 3279

T.D. 3288 Set 5 $\frac{1}{2}$ " 3280

Drilled plugs Made 1/2 gallon oil per hour Washed hole with 100 gallons acid

Made about 1 $\frac{1}{2}$ gallons oil per hour

Hole still muddy May wash hole again with acid before acidizing under pressure

Will not deepen (Tel)

10/31--T.D. 3288 Acidized 1000 gallons thru tubing Pumped 10 bbls. net oil per hour off bottom No water (Do not know how many hours was pumped)

Will reacidize with 1500 gallons (Tel)

11/1--T.D. 3288 Reacidized 1500 gallons Pumping 16 to 17 bbls. per hour for 14 hours 700 feet. off bottom Still pumping

11/2--Pumped 17 bbls. per hour for 24 hours No water Will reacidize (Tel)

11/4--Reacidized with 4000 gallons Did not help Pumped 13 to 14 bbls. per hour for 24 hours No water Will take a state potential (Tel)

11/7--Took 8 hour pumping test 24 hour pumping potential 393 bbls. No water (Tel)

11/13 Arb. 3279' .
5" - 3280'
T.D. 3288'
7500 acid.

Potential 393 bbls., pump.

COMPLETED

Map No. 55 Sec. 27 Twp. 16 R. 10WWell No. 3 Stoltenberg "E"Atlantic etal Company

Contractor

COMPLETED**SECTION PLAT**

-C S L SW SE

 Ft. from N. Line330 Ft. from S. Line Ft. from E. Line660 Ft. from W. Line

STOLTENBERG POOL

Location Rig up

Drilling and Remarks:

*Cor. 3279.**5" @ 3280**7500 acid**Pump 393 Pk.***RECORD**Cased in., ft.Sand Gas Oil Total Depth 3288**PRODUCTION**1st 24 hrs. Nat. 1st 24 hrs. after shot Gas Cu. Ft.Dry Hole Abandoned

Date

NOV 13 1940 19 S. J. LEWIS Scout