

KANSAS

FORM 51 5M 1-42 PETROL

Ellsworth

Section 27 Township 16 Range 10-W

Well No. #5 Stoltenberg "E"

Company Atlantic

NORTH

|  |  |  |  |  |  |  |  |
|--|--|--|--|--|--|--|--|
|  |  |  |  |  |  |  |  |
|  |  |  |  |  |  |  |  |
SOUTH

15

EAST

WEST

**KANSAS**

Ellsworth

Sec. 27 Twp. 16 R. 10 W

Well No. #5 Stoltenberg "E" Farm

Atlantic Company

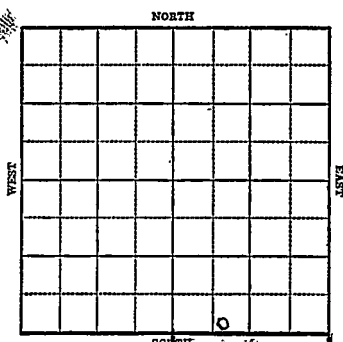
**Stoltenberg**

         Ft. from N. Line

180 Ft. from S. Line

         Ft. from E. Line

770 Ft. from W. Line



1943

Elev. 1810 R E P O R T

6/9

S. W. D.  
Derrick

6/16

10" @ 678'  
WOC

6/23

Drlg. 3200'

6/30

Drlg. 3759'  
Run 7"

7/7

7" @ 3747'  
Drlg. 3850'

7/14

T.D. 3866'  
500 acid  
Input 300 gals. water a minute.

7/21

" "

7/28

Arb. 3291  
Reagan 3745  
Granite 3840  
T.D. 3840'  
5000 gal. acid  
7" @ 3747'  
SWD

**ABANDONED**

Ellsworth

KANSAS

Map No. 55 Sec. 27 Twp. 16 R. 10WWell No. 5 Stoltenberg "E"

Atlantic

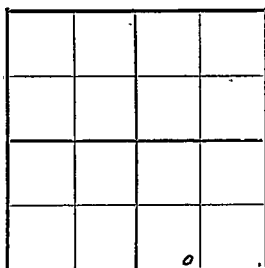
Company

FIRST REPORT

Contractor

SE SW SE

SECTION PLAT

           Ft. from N. Line180 Ft. from S. Line           Ft. from E. Line770 Ft. from W. Line

STOLTENBERG POOL

M.C.D.C.

Location                                 Rig up                                 

Drilling and Remarks:

S.W.D.

Derrick

RECORD

Cased            in.,            ft.Sand                                 Gas                                 Oil                                 Total Depth                                 

PRODUCTION

1st 24 hrs. Nat.                                 1st 24 hrs. after shot                                 Gas                                  Cu. Ft.Dry Hole                                 Abandoned                                 

Date

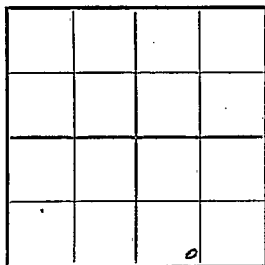
JUN 9 1943 19

S. J. LEWIS Scout

KANSAS Ellsworth

Map No. 55 Sec. 27 Twp. 16 R. 10WWell No. 5 Stoltenberg "E"Atlantic Company~~COMBINED~~ Contractor

SE SW SE

~~ABANDONED~~ SECTION PLAT         Ft. from N. Line180 Ft. from S. Line         Ft. from E. Line770 Ft. from W. Line

STOLTENBERG POOL

Location         Rig up         

Drilling and Remarks:

*Ar 83291**Reagan 3745**Reagan 3740**5000 acid**7" C 3747**S. J. Lewis*

## RECORD

Cased          in.,          ft.Sand         Gas         Oil         Total Depth 3840

## PRODUCTION

1st 24 hrs. Nat.         1st 24 hrs. after shot         Gas          Cu. Ft.Dry Hole         Abandoned         

Date

JUL 28 1943 19

S. J. LEWIS Scout