

KANSAS

Form 51-5M-7-39-Palace


Ellsworth

Section 27 Township 16 Range 10-W

Well No. #1 J.A.Stoltenberg "E"

Company Atlantic, Stanolind & Gulf

NORTH Stoltenberg Pool

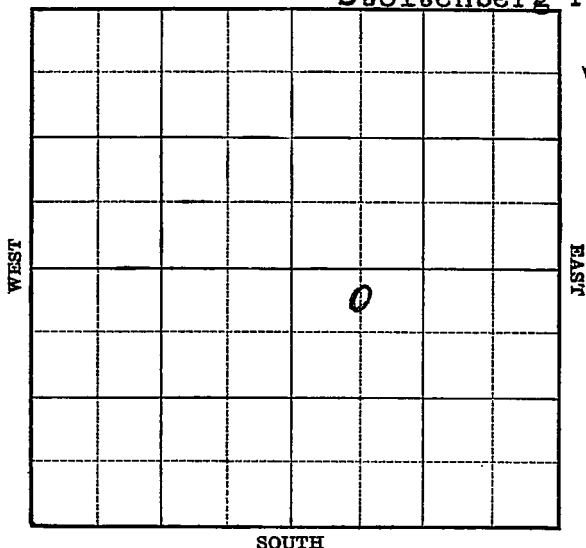

KANSAS

Ellsworth

Sec. 27 Twp. 16 R. 10-WWell No. #1 J. A. Stoltenberg "E" FarmAtlantic, Stanolind & Gulf Company

(Stoltenberg)


330 Ft. from N. Line

Ft. from S. Line

Ft. from E. Line

660 Ft. from W. Line

Elev. 1823

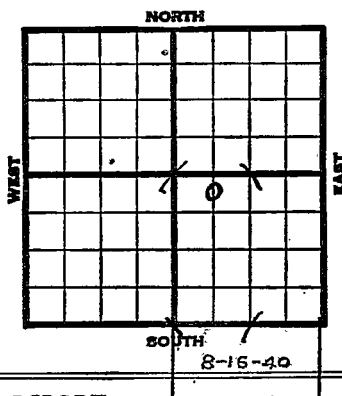

REPORT

1940

2/7 Location

2/15 "

2/23 "

2/29 R.U.R.

3/8 10" - 370' Anhy 5% O'

Drilg. 1710'

3/14 Topeka 2593' Lans. 2947'

Drilg. 3035'

3/18 Top Arbuckle 3272 Cored 3273-76

Core showed good show oil and good

porosity T.D. 3276 5 $\frac{1}{2}$ " 3271 $\frac{1}{2}$

Drilled plugs Filled up 3000 feet oil

in 25 minutes No water

Building tanks (Tel)

Running 22' higher on Arbuckle than Leuck &
Moncrief #1 Ehler 35-16-10W

3/21 Arb. 3272' 5" - 3272'

T.D. 3276' 3000' oil 25 minutes

Swab 93 bbls. 1 hour.

43. Gravity

3/25 Echometer potential 24,903 bbls. OVER

Maximum allowed 3000 bbls. (Tel)

1940

3/27

Arb. 3272'

5" - 3272'

T.D. 3276'

Ecometer potential 24,903 bbls.

Maximum 3000 bbls.

COMPLETED

Map No. 53 Sec. 27 Twp. 16 R. 10WWell No. 1 J. A. Stoltenberg "E"
Atlantic, Stanolind & Gulf
Company

Contractor

FIRST REPORT

C N $\frac{1}{2}$ NW SE

SECTION PLAT

		o	

330 Ft. from N. Line Ft. from S. Line Ft. from E. Line660 Ft. from W. Line

STOLTENBERG POOL

Location XRig up

Drilling and Remarks:

*Special**We have N $\frac{1}{2}$ NE**34-16-10W.*

RECORD

Cased in., ft.Sand Gas Oil Total Depth

PRODUCTION

1st 24 hrs. Nat. 1st 24 hrs. after shot Gas Cu. Ft.Dry Hole Abandoned

Date

FEB 7 1940 19

S. J. LEWIS

Scout

Map No. 55 Sec. 27 Twp. 16 R. 10WWell No. 1 J. A. Stoltenberg "E"Atlantic & Stanolind Company

Contractor

COMPLETED

C $N\frac{1}{2}$ NW SE

SECTION PLAT

330 Ft. from N. Line Ft. from S. Line Ft. from E. Line660 Ft. from W. Line

		0	

STOLTENBERG POOL

Location Rig up

Drilling and Remarks:

*On 83272**5" @ 3272**Echometer Log**24903**Maximum 3000*

RECORD

Cased in., ft.Sand Gas Oil Total Depth 3276

PRODUCTION

1st 24 hrs. Nat. 1st 24 hrs. after shot Gas Cu. Ft.Dry Hole Abandoned

Date

S. J. LEWIS

MAR 27 1940 19

Scout