

KANSAS

Form 51-5M-7-39-Palace


Ellsworth


Section 28 Township 16 Range 10-W

Well No.: #1 Loula

Company Gulf

NORTH Stoltenberg Pool

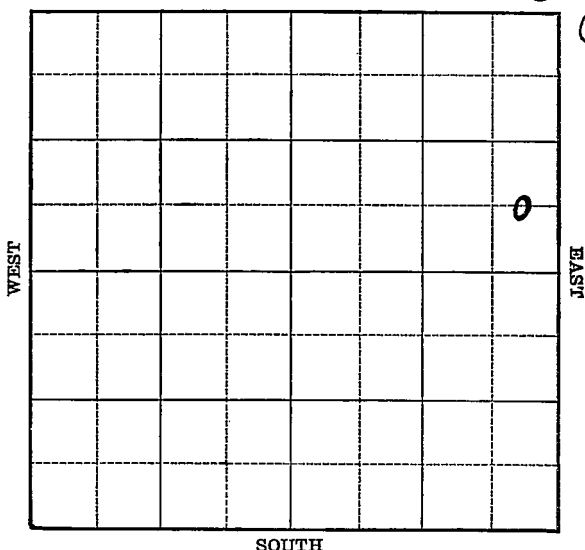

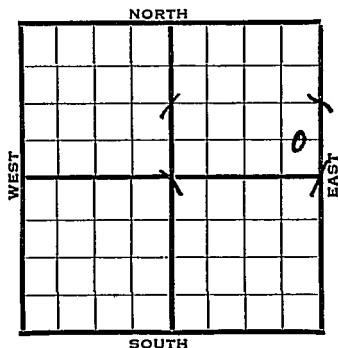[illegible]

Map No. 55 Sec. 28 Twp. 16 R. 10WWell No. 1 LoulaGulf

Company

Contractor

FIRST REPORT

C E L S E NE

SECTION PLAT

 Ft. from N. Line660 Ft. from S. Line330 Ft. from E. Line Ft. from W. Line

STOLTENBERG POOL

Location XRig up

Drilling and Remarks:

RECORD

Cased in., ft.Sand Gas Oil Total Depth

PRODUCTION

1st 24 hrs. Nat. 1st 24 hrs. after shot Gas Cu. Ft.Dry Hole Abandoned

Date

MAR 20 1940

19

S. J. LEWIS

Scout

Map No. 55 Sec. 28 Twp. 16 R. 10WWell No. 1 LoulaGulf Company

Contractor

ABANDONED**C E L S E N E**

Ft. from N. Line

660

Ft. from S. Line

330

Ft. from E. Line

Ft. from W. Line

SECTION PLAT

			o

STOLTENBERG POOL

Location _____

Rig up _____

Drilling and Remarks:

Comp 3297
No True Act.

RECORD

Cased _____ in., _____ ft.

Sand _____

Gas _____

Oil _____

Total Depth 3344**PRODUCTION**

1st 24 hrs. Nat. _____

1st 24 hrs. after shot _____

Gas _____ Cu. Ft.

Dry Hole _____

Abandoned _____

Date

APR 17 1940₁₉S. J. LEWIS Scout