


Section 28 Township 16 Range 10W

Well No. 3 Loula "B"

Company Murfin et al

Stoltenberg Pool
NORTH

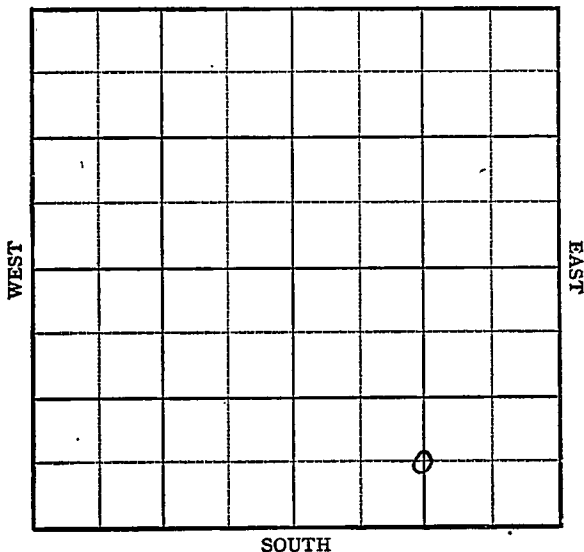

Sec. 28 Twp. 16 R. 10-W ✓

Well No. #3 Loula "B" Farm

Murfin et al. Company

Stoltenberg Pool


 Ft. from N. Line

660 Ft. from S. Line

1320 Ft. from E. Line

 Ft. from W. Line

C S $\frac{1}{2}$ SE

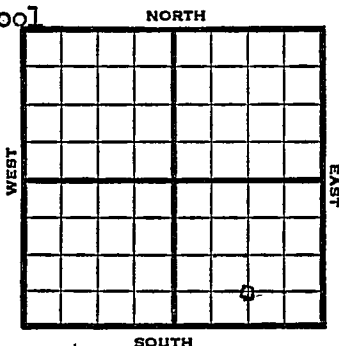

1948 Eli 1815' REPORT

11/3 Drlg 1590
SWD

11/10 8" @ 291'
Arbuckle 3272'
TD 3755 in Granite Wash
Run 5"

11/16 5" @ 3350'
TD 3765'

11/23 "

11/30 "

12/8 "

12/15 TD 3755' in Granite
5" @ 3350'
SWD
Aband.

ABANDONED

Map No. _____ Sec. 28 Twp. 16 R. 10W


Well No. 3 Loula "B"

Murfin et al. _____ Company

FIRST REPORT _____ Contractor

C S $\frac{1}{2}$ SE

SECTION PLAT

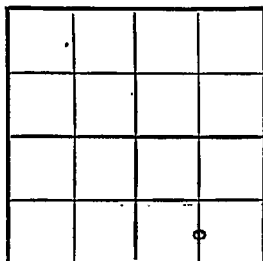

_____ Ft. from N. Line

660 _____ Ft. from S. Line

1320 _____ Ft. from E. Line

_____ Ft. from W. Line

Ellsworth County

RECORD

Location _____

Rig up _____

Drilling and Remarks:

drlg. 1590

SWD

Cased _____ in., _____ ft.

Sand _____

Gas _____

Oil _____

Total Depth _____

PRODUCTION

1st 24 hrs. Nat. _____

1st 24 hrs. after shot _____

Gas _____ Cu. Ft.

Dry Hole _____

Abandoned _____

Date

NOV 3 1948 19

S. J. LEWIS

Scout

Map No. 55 Sec. 28 Twp. 16 R. 10W

Well No. 3 Loula "B" SWD

Murfin et al.

Company

ABANDONED

Contractor

C S $\frac{1}{2}$ SE

E. 1. 1875
SECTION PLAT

 Ft. from N. Line

660 Ft. from S. Line

1320 Ft. from E. Line

 Ft. from W. Line

Ellsworth County

Location

Rig up

Drilling and Remarks:

5" @ 3350

SWD

RECORD

Cased in., ft.

Sand

Gas

Oil

Total Depth 3755 in. *in. in.*

PRODUCTION

1st 24 hrs. Nat.

1st 24 hrs. after shot

Gas Cu. Ft.

Dry Hole

Abandoned

Date

DEC 15 1948

S. J. LEWIS

Scout