


KANSAS

Ellsworth county  
Bloomer Pool

Section 28 Township 16 Range 10W

Well No. 2 Loula "A"

Company I. W. Murfin

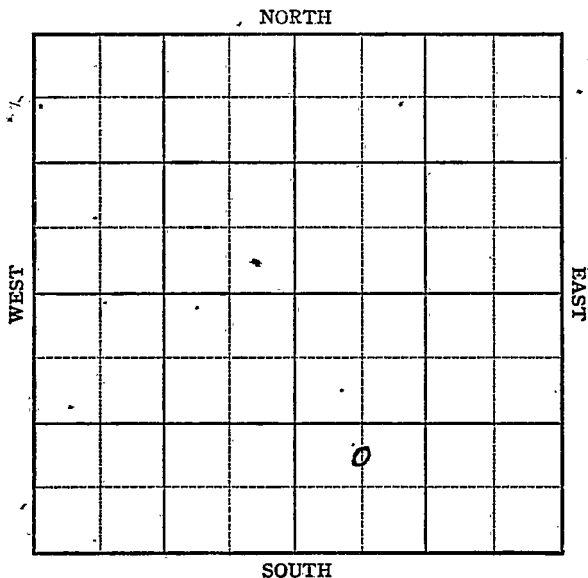

KANSAS

Ellsworth

Sec. 28 Twp. 16. R. 10-W

Well No. #2 Loula "A" Farm

I. W. Murfin Company

Bloomer Pool

Ft. from N. Line


990

Ft. from S. Line

Ft. from E. Line

660

Ft. from W. Line

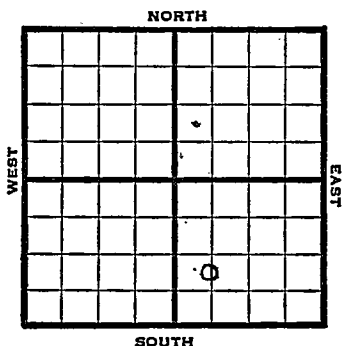

C N L SW SE

1947 Elev. 1837' REPORT

4/16 Drlg 2800'

4/23 Lans 2982  
BKC 2280  
Arb 3313  
TD 3315'  
5" @ 3313  
RUST

4/29 TD 3320'  
500 Acid

5/7 500 acid  
2800' oil in 12 hrs

5/13 Swb. 7 bbls. oil ph 24 hrs.

5/20 " "

5/27 " "

6/3 " "

6/10 " "

6/17 " "

6/24 " "

7/1 " "

7/8 " "

OVER

7-16 Swb. 7 bbls. oil ph 24 hrs.

7/16 Arbuckle 3313'  
5" @ 3313'  
1000 Acid  
Pump 153 oil / 30% W Pot.  
Gr. 42  
T.D. 3320'  
Completed

Map No. 55 Sec. 28 Twp. 16 R. 10W

Well No. 2 Loula "A"

I. W. Murfin Company

FIRST REPORT Contractor

C N L SW SE

SECTION PLAT

       Ft. from N. Line

990 Ft. from S. Line

       Ft. from E. Line

660 Ft. from W. Line

|  |  |   |  |
|--|--|---|--|
|  |  |   |  |
|  |  |   |  |
|  |  |   |  |
|  |  | o |  |

Ellsworth County

Location                     

Rig up                     

Drilling and Remarks:

drlg. 2800

RECORD

Cased            in.,            ft.

Sand                     

Gas                     

Oil                     

Total Depth                     

PRODUCTION

1st 24 hrs. Nat.                     

1st 24 hrs. after shot                     

Gas                      Cu. Ft.

Dry Hole                     

Abandoned                     

Date

APR 16 1947 19 S. J. LEWIS Scout

Map No. 55 Sec. 28 Twp. 16 R. 10W

Well No. 2 Loula "A"

I. W. Murfin Company

**COMPLETE**

Contractor

C N L SW SE

E 11837

**SECTION PLAT**

           Ft. from N. Line

990 Ft. from S. Line

           Ft. from E. Line

660 Ft. from W. Line

|  |  |   |  |
|--|--|---|--|
|  |  |   |  |
|  |  |   |  |
|  |  |   |  |
|  |  | 0 |  |

Ellsworth County

Location                                 

Rig up                                 

Drilling and Remarks:

*Cu 48313*  
*5" @ 3313*  
*10000 cu ft*  
*Pump 153 oil +*  
*35% W P 28*  
*420 lb*

**RECORD**

Cased            in.,            ft.

Sand                                 

Gas                                 

Oil                                 

Total Depth 2820

**PRODUCTION**

1st 24 hrs. Nat.                                 

1st 24 hrs. after shot                                 

Gas                                  Cu. Ft.

Dry Hole                                 

Abandoned                                 

Date

JUL 16 1947 19 S. J. LEWIS Scout