


Section 28 Township 16 Range 10-W

Well No. #5 'Loula' A"

Company I. W. Murfin etal
Bloomer

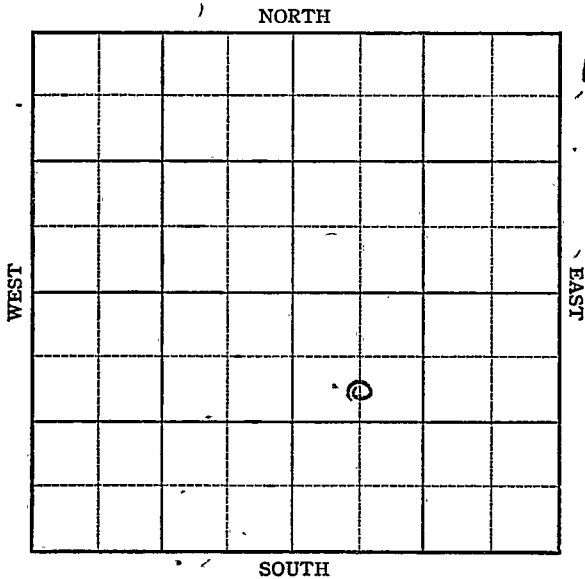

KANSAS

Sec. 28 Twp. 16 R. 10-W

Well No. #5 Loula "A" Farm

I. W. Murfin et al. Company

Bloomer Pool

990


Ft. from N. Line

Ft. from S. Line

Ft. from E. Line

660 Ft. from W. Line

C S L NW SE

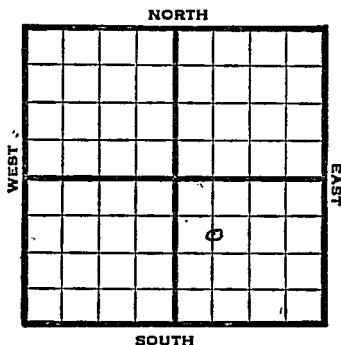

1947 Elev 1837' REPORT

6/18 Location

6/24 "

7/1 "

7/8 "

7/16 "

7/22 "

8/6 "

8/13 "

8/20 "

8/27 8" @ 343

WOO

9/3 Topeka 2655

Drilg. 2840

9/10 Lansing 2982'

Arbuckle 3278'

TD 3283'

5" @ 3281

RUST.

OVER

1947

9/17 TD 3289'
.500 acid
1400' oil 14 hrs.

9/24 "

10/1 Pump 18 oil in 4 hrs.


10/8 Arbuckle 3278'
5" @ 3281'
Pump 92 Pot.
TD 3289'
Gravity 42

COMPLETED

Map No. 55 Sec. 28 Twp. 16 R. 10WWell No. 1 Loula "A"I. W. Murfin et al. CompanyFIRST REPORT Contractor

C S L NW SE

SECTION PLAT

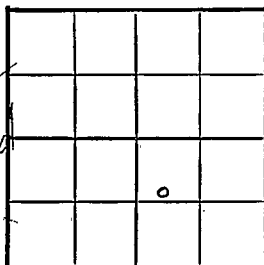990 Ft. from N. Line Ft. from S. Line Ft. from E. Line660 Ft. from W. LineEllsworth CountyLocation XRig up

Drilling and Remarks:

RECORD

Cased in., ft.Sand Gas Oil Total Depth

PRODUCTION

1st 24 hrs. Nat. 1st 24 hrs. after shot Gas Cu. Ft.Dry Hole Abandoned

Date

JUN 18 1947 19 S. J. LEWIS Scout

Map No. 55 Sec. 28 Twp. 16 R. 10W

Well No. 5 Loula "A"

I. W. Murfin et al.

Company

CORRECTION

Contractor

C S L NW SE


SECTION PLAT

990 Ft. from N. Line

 Ft. from S. Line

 Ft. from E. Line

660 Ft. from W. Line

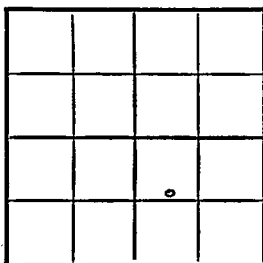

Ellsworth County

Location

Rig up

Drilling and Remarks:

Reported

#1 Loula "A"

RECORD

Cased in., ft.

Sand

Gas

Oil

Total Depth

PRODUCTION

1st 24 hrs. Nat.

1st 24 hrs. after shot

Gas Cu. Ft.

Dry Hole

Abandoned

Date

JUN 18 1947 19

S. J. LEWIS

Scout

Map No. 55 Sec. 28 Twp. 16 R. 10W

Well No. 5 Loula "A"

L. W. Murfin et al. Company

COMPLETE

Contractor

C S L NW SE


E. 1. 1805
SECTION PLAT

990 Ft. from N. Line

 Ft. from S. Line

 Ft. from E. Line

660 Ft. from W. Line

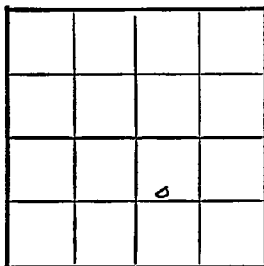

Ellsworth County

Location

Rig up

Drilling and Remarks:

Cor 43228.

5" 43228.

Pump 92 P.D.

42 6/8

RECORD

Cased in., ft.

Sand

Gas

Oil

Total Depth 8289

PRODUCTION

1st 24 hrs. Nat.

1st 24 hrs. after shot

Gas Cu. Ft.

Dry Hole

Abandoned

Date

OCT 8 1947 19

S. J. LEWIS Scout