

KANSAS

Form 51—5M—7-39—Palace


Ellsworth

Section 28 Township 16 Range 10-W

Well No. #1 Schroeder

Company Stanolind

NORTH Stoltenberg Pool

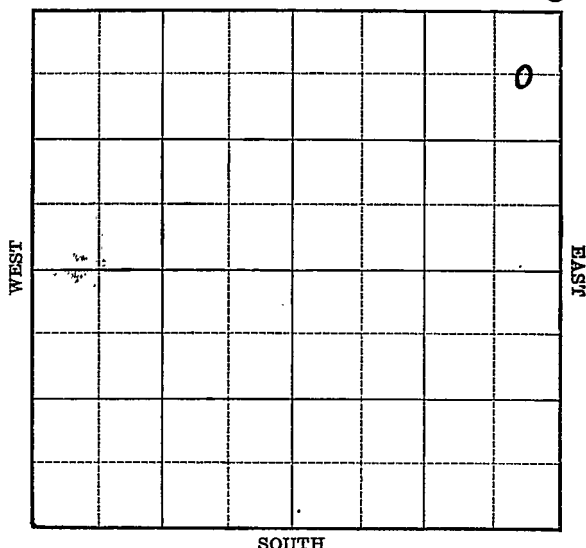

KANSAS


Ellsworth

Sec. 28 Twp. 16 R. 10-WWell No. #1 Schroeder FarmStanolind Company

(Stoltenberg)

660 Ft. from N. Line Ft. from S. Line330 Ft. from E. Line Ft. from W. Line

Elev. 1842

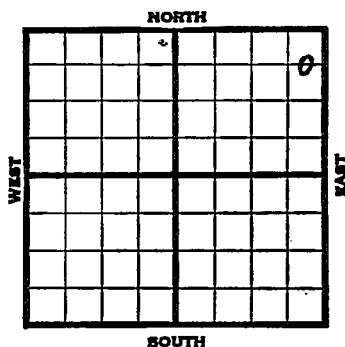**1949**

REPORT

1/3	Location
1/11	"
1/18	"
1/25	Derrick.
2/1	8" - 255' WOC.
2/8	Anhy 614' Drlg. 1755'
2/15	Drlg. 2985'
2/23	Lans. 2996' Arb. 3298'
	5½" - 3305' T.D. 3310' Sat.
	RUST.
2/29	T.D. 3316' 400 acid.
	Shot 10 qts. 3301-16'
	Fsg. sand pump.
3/8	1000 acid.

OVER

1940

3/13

Arb. 3298'

5 $\frac{1}{2}$ " - 3290 $\frac{1}{2}$ '

T.D. 3316'

Shot 10 qts. 3306-16'

400 acid.

Pump 457 bbls., plus 2% water.

COMPLETED

Ellsworth

Map No. 53 Sec. 28 Twp. 16 R. 10WWell No. 1 Schroeder

Stanolind

Company

Contractor

FIRST REPORT

C E $\frac{1}{2}$ NE NE660 Ft. from N. Line Ft. from S. Line330 Ft. from E. Line Ft. from W. Line

SECTION PLAT

			8

STOLTENBERG POOL

Location XRig up

Drilling and Remarks:

RECORD

Cased in., ft.Sand Gas Oil Total Depth

PRODUCTION

1st 24 hrs. Nat. 1st 24 hrs. after shot Gas Cu. Ft.Dry Hole Abandoned

Date

JAN 3 1940

19

Scout

Map No. 55 Sec. 28 Twp. 16 R. 10WWell No. 1 SchroederStanolind

Company

Contractor

COMPLETED

C E $\frac{1}{2}$ NE NE660 Ft. from N. Line

Ft. from S. Line

330 Ft. from E. Line

Ft. from W. Line

STOLTENBERG POOL

SECTION PLAT

			D

Location _____

Rig up _____

Drilling and Remarks:

*Ac 83298.**5 1/2 "C 3290 1/2**Shot 109 to 3306-16**4000 cu ft**Pump 457 plus 290*

RECORD

Cased _____ in., _____ ft.

Sand _____

Gas _____

Oil _____

Total Depth 3316

PRODUCTION

1st 24 hrs. Nat. _____

1st 24 hrs. after shot _____

Gas _____ Cu. Ft.

Dry Hole _____

Abandoned _____

Date

MAR 13 1940S. J. LEWIS

Scout