



Sec. 28 Twp. 16 R. 10-WWell No. #1 Schroeder FarmW. C. Emerich et al Company


(Stoltenberg)

\_\_\_\_\_ Ft. from N. Line

660 Ft. from S. Line330 Ft. from E. Line

\_\_\_\_\_ Ft. from W. Line

Elev. 1851

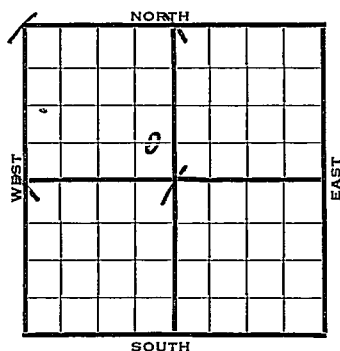

1940	REPORT
8/7	Derrick.
8/14	Rigging up
8/22	10" - 238' WOC.
8/29	Anhy 630' Drlg. 1730'
9/5	SD 2000'
9/12	Drlg. 2609'
9/19	Lans. <del>2998</del> <sup>3000</sup> ' Drlg. 3143'
9/26	Topeka 2620'
	Lans. 3000' (Corrected)
	TD 3143' SD.
10/3	Cong. 3297' Arb. 3303'
	Coring 3308' no shows.
10/10	T.D. 3319½' SSO. 5½" - 3311'
	RUST.
10/17	"
10/24	"
10/31	"
11/7	T.D. 3328' 1600 acid. Testing.
11/14	2000 acid. Pump 20 bbls. per hour, 30% acid water.
11/21	" " "

- OVER

1940

11/27

TD 3328'

Pump 20 bbls. per hour; 30%  
acid water.

12/5

" "

12/12

Shut down.

12/19

" "

12/26

" "

1941

1/2

" "

1/9

" "

1/15

Arb. 3303'

5" - 3311'

T.D. 3328'

3600 acid.


Potential 125 bbls., pump.

42.7 Gravity

COMPLETED

Map No. 55 Sec. 28 Twp. 16 R. 10WWell No. 1 SchroederW. C. Emerich etal Company

Contractor

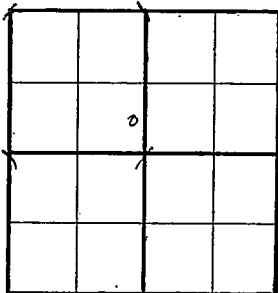**FIRST REPORT****C E L S E N W****SECTION PLAT**

\_\_\_\_\_ Ft. from N. Line

660 Ft. from S. Line330 Ft. from E. Line

\_\_\_\_\_ Ft. from W. Line

**STOLTENBERG POOL**

Location \_\_\_\_\_

Rig up \_\_\_\_\_

Drilling and Remarks:

**Derrick****RECORD**

Cased \_\_\_\_\_ in., \_\_\_\_\_ ft.

Sand \_\_\_\_\_

Gas \_\_\_\_\_

Oil \_\_\_\_\_

Total Depth \_\_\_\_\_

**PRODUCTION**

1st 24 hrs. Nat. \_\_\_\_\_

1st 24 hrs. after shot \_\_\_\_\_

Gas \_\_\_\_\_ Cu. Ft.

Dry Hole \_\_\_\_\_

Abandoned \_\_\_\_\_

Date

AUG 7 1949S. J. LEWIS Scout

Map No. 55 Sec. 28 Twp. 16 R. 10WWell No. 1 Schroeder

W. C. Emerich et al

Company

Contractor

**COMPLETED**

C E L S E N W

\_\_\_\_\_ Ft. from N. Line

660 Ft. from S. Line

330 Ft. from E. Line

\_\_\_\_\_ Ft. from W. Line

**SECTION PLAT**

		b	

**STOTTENBERG POOL**

Location \_\_\_\_\_

Rig up \_\_\_\_\_

Drilling and Remarks:

*CEL 83308**5" @ 83311**3600 acid**Pump 125 P.S.T.**422 G.P.***RECORD**

Cased \_\_\_\_\_ in., \_\_\_\_\_ ft.

Sand \_\_\_\_\_

Gas \_\_\_\_\_

Oil \_\_\_\_\_

Total Depth 3328**PRODUCTION**

1st 24 hrs. Nat. \_\_\_\_\_

1st 24 hrs. after shot \_\_\_\_\_

Gas \_\_\_\_\_ Cu. Ft.

Dry Hole \_\_\_\_\_

Abandoned \_\_\_\_\_

Date

JAN 15 1941 19

S. J. LEWIS Scout