
KANSAS Ellsworth

FORM 51 5M PETROL

Section 28 Township 16 Range 10W

Well No. 1 Schroeder

Company Artmell

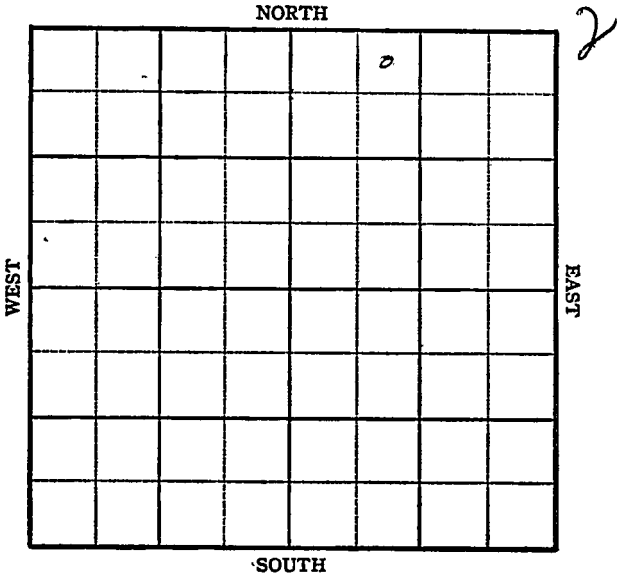

FORM 252-A
5M 8-45 PETROL

KANSAS Ellsworth

Sec. 28 Twp. 16 R. 10-W

Well No. #1 Schroeder Farm

Artmell Company


330 Ft. from N. Line

Ft. from S. Line

Ft. from E. Line

990 Ft. from W. Line

NE NW NE

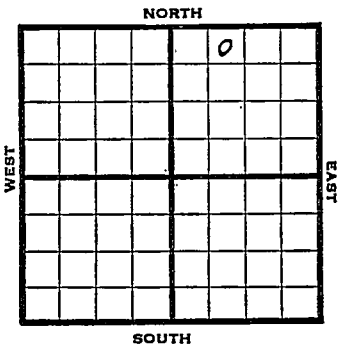

	REPORT
1945	Elev. 1841'
10/24	RUR
10/31	8" @ 330 Anhy 784 Drlg. 2125
11/7	Drlg. 3265
11/14	Lans 2972 Arb. 3287 5" @ 3288 TD 3305 2000' oil 8 hrs.
11/21	" " "
11/28	" " "
12/5	" " "
12/12	500 acid. 2600' oil
12/20	" "
12/29	Depth Test 700 bbls. oil.
1946	
1/9	Arb. 3287 5" @ 3288 500 acid. TD 3305 Pump 86 Pot. Grav. 42.0

COMPLETED

FORM 56 200 BKS, 1-44 PETROL

KANSAS Kansas Pool Name Stoltenberg

Map No. 55 Sec. 28 Twp. 16 R. 10W

Well No. 1 Schroeder

Artmell Company

FIRST REPORT

Contractor

NE NW NE


330 Ft. from N. Line

Ft. from S. Line

Ft. from E. Line

990 Ft. from W. Line

SECTION PLAT

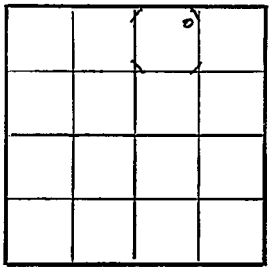

Ellsworth County

Location

Rig up

Drilling and Remarks:

RUR

RECORD

Cased in., ft.

Sand

Gas

Oil

Total Depth

PRODUCTION

1st 24 hrs. Nat.

1st 24 hrs. after shot

Gas Cu. Ft.

Dry Hole

Abandoned

Date

OCT 2 4 1945 19

S. J. LEWIS Scout

FORM 26 200 BKS 1-44 PETROL

KANSAS / Kansas Pool Name Stoltenberg

Map No. 33 Sec. 28 Twp. 16 R. 10W

Well No. 1 Schroeder


Artmell Company

COMPLETED Contractor

NE NW NE

E.L. 1841

SECTION PLAT

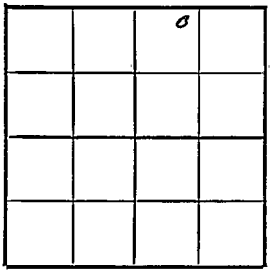

330 Ft. from N. Line

Ft. from S. Line

Ft. from E. Line

990 Ft. from W. Line

Ellsworth County

Location

Rig up

Drilling and Remarks:

Cer # 8287

5 "C 8288"

5 acid

Pump 86 BO

42 ° Gr

RECORD

Cased in., ft.

Sand

Gas

Oil

Total Depth 2945

PRODUCTION

1st 24 hrs. Nat.

1st 24 hrs. after shot

Gas Cu. Ft.

Dry Hole

Abandoned

Date

JAN 9 1946 19 S. J. LEWIS Scout