
KANSAS Ellsworth

FORM 51 5M PETROL

Section 28 Township 16 Range 10W

Well No. 2 G. H. Schroeder

Company Artmell

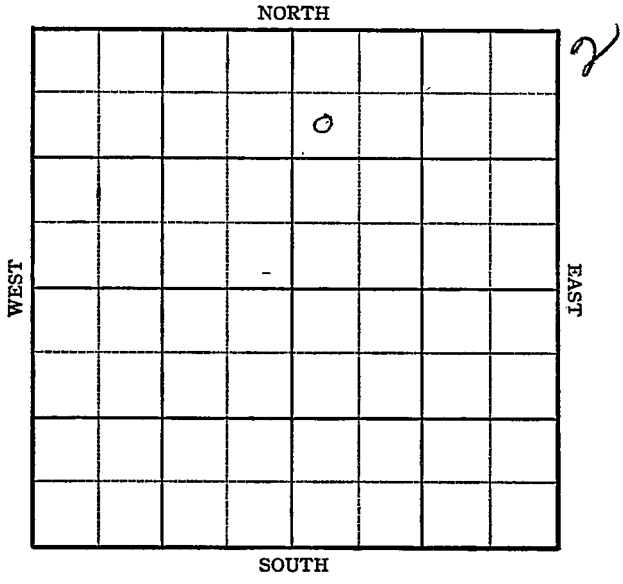

FORM 252-A
5M 8-45 PETROL

KANSAS Ellsworth

Sec. 28 Twp. 16 R. 10-W

Well No. #2 G. H. Schroeder Farm


Artmell Company

990 Ft. from N. Line

_____ Ft. from S. Line

_____ Ft. from E. Line

330 Ft. from W. Line

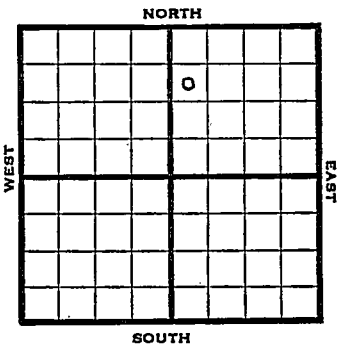

SW NW NE

1945	REPORT Elev. 1849
11/21	RUR
11/28	8" @ 319 Drlg. 1495
12/5	Lans. 2990 Drlg. 3012
12/12	5" @ 3304 RUST
12/20	Arb. 3301' T.D. 3304' RUST.
12/29	T.D. 3326' 500 acid. Pump 10 oil in 24 hours.
1946 1/10	" " 2
1/17	Pump 128 oil in 24 hours.
1/23	Arb. 3301 5" @ 3304 1000 acid. TD 3326 Pump 128 Pot. Grav. 42.0

COMPLETED

FORM 26 200 BKS 1-44 PETROL

KANSAS Kansas Pool Name Stoltenberg

Map No. S S Sec. 28 Twp. 16 R. 10W

Well No. 2 G. H. Schroeder

Artmell Company

FIRST REPORT Contractor

SW NW NE


990 Ft. from N. Line

Ft. from S. Line

Ft. from E. Line

330 Ft. from W. Line

SECTION PLAT

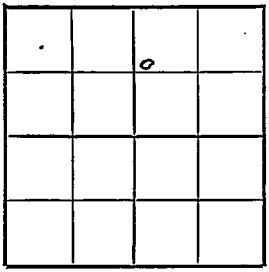

Ellsworth County

Location

Rig up

Drilling and Remarks:

R U R

RECORD

Cased in., ft.

Sand

Gas

Oil

Total Depth

PRODUCTION

1st 24 hrs. Nat.

1st 24 hrs. after shot

Gas Cu. Ft.

Dry Hole

Abandoned

Date

NOV 2 1 1945 19

S. J. LEWIS Scout

FORM 26 200 BKS 1-44 PETROL

KANSAS Kansas Pool Name Stoltenberg Pool

Map No. 56 Sec. 28 Twp. 16 R. 10W

Well No. 2 G. H. Schroeder

Artmell Company

COMPLETED Contractor

El. 1849

SW NW NE


SECTION PLAT

990 Ft. from N. Line

Ft. from S. Line

Ft. from E. Line

330 Ft. from W. Line

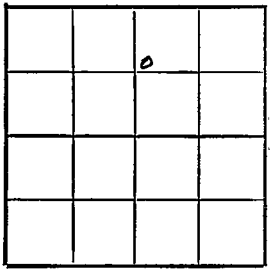

Ellsworth County

Location

Rig up

Drilling and Remarks:

Cr 3301

5" @ 3304

100 acid

Pump 125 B.O.

42 gr

RECORD

Cased in., ft.

Sand

Gas

Oil

Total Depth 3326

PRODUCTION

1st 24 hrs. Nat.

1st 24 hrs. after shot

Gas Cu. Ft.

Dry Hole

Abandoned

Date

JAN 23 1946 19 S. J. LEWIS Scout