


KANSAS

Ellsworth

Section 28 Township 16 Range 10W

Well No. 1 Schroeder

Company Harms-Burt, C-C Pet.

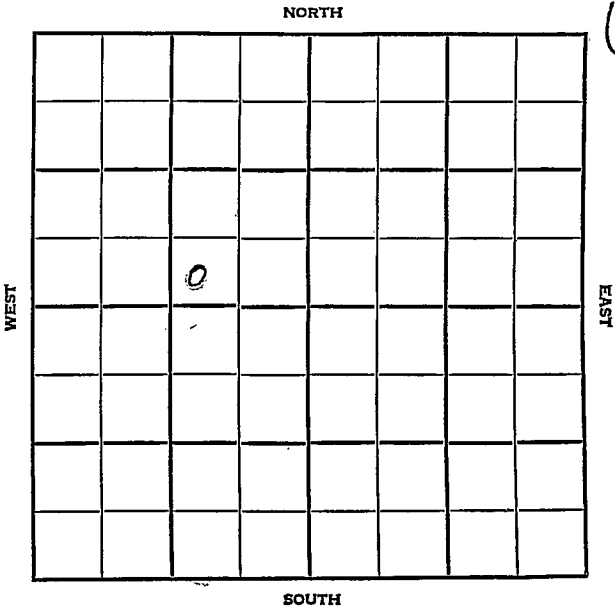

Ellsworth

KANSAS

SEC.	TWP.	R.
28	16	10 W

WELL NO.

1 Schroeder

FARM

COMPANY

Harms-Burt, C-C Pet.

CONTRACTOR

Stoltenberg


Ft. from N. Line

Ft. from S. Line

Ft. from E. Line

Ft. from W. Line

SW SE NW

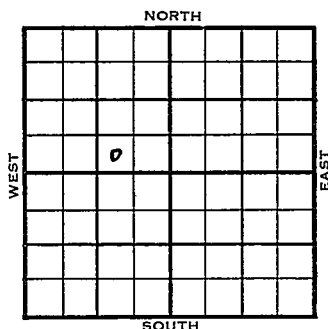

ELEVATION

REPORT

1955

6/29

8" @ 229

D & A

Heeb 2862', Br. L. 2962', Lansing

2980', Arbuckle 3327'

TD 3337' D & A

FIRST REPORT

ABANDONED

County Ellsworth Elev. 1837Sec. 28 Twp. 16 Rge. 10WCompany Harms-Burt, C-C Pet.Farm Name Schroeder No. 1

TOPS	DEPTH	LOG	DATUM
Anh.			
TP.			
H.	2862		
Tr.			
Dg.			
BL.	2962		
L.	2980		
K.C.			
B.K.C.			
Ce.			
C.			
M.			
M.			
K.			
Mz.			
Me.			
V.			
S.			
S.			
A	3327		
R.			
PE.			
G.			
T.D.	3337		

Loc. in Sec. SW SE NWGeol. Contr. Pool

Steltenberg

ABANDONED

10

FIRST REPORT
JUN 29 '55Date Comm. 8th @ 229

D & A