

KANSAS


Ellsworth

FORM 51 5M PETROL

Section 28 Township 16 Range 10W

Well No. 4 Schroeder

Company Lion Oil

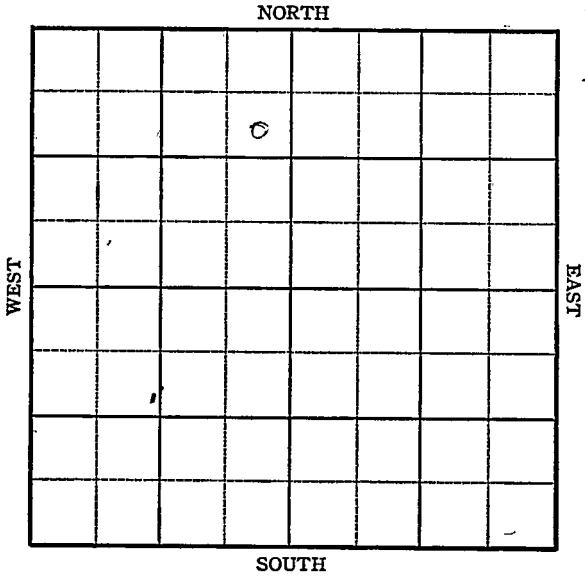

Sec. 28 Twp. 16 R. 10-W

Well No. #4 Schroeder Farm


Lion Oil Company

990 Ft. from N. Line

 Ft. from S. Line

330 Ft. from E. Line

 Ft. from W. Line

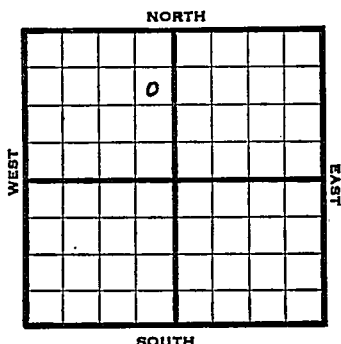

SE NE NW

1945 Elev. 1851 REPORT

11/21 RUR

11/28 8" @ 608

Drlg. 900'

12/5 Drlg. 2225

12/12 Lans 2987

Arb. 3304-3307

TD 3307

5" @ 3305 RUST

12/20 T.D. 3331' 800' oil 2 hours.

12/29 Pump 65 oil in 16 hours.

1946

1/9 Arb. 3304

5" @ 3305

TD 3331

Pump 73 Pot.

Grav. 42.0

COMPLETED

KANSAS

Kansas Pool Name StoltenbergMap No. 55 Sec. 28 Twp. 16 R. 10WWell No. 4 SchroederLion Oil

Company

FIRST REPORT

Contractor

SE NE NW

SECTION PLAT

990 Ft. from N. Line Ft. from S. Line330 Ft. from E. Line Ft. from W. LineEllsworth CountyLocation Rig up

Drilling and Remarks:

R U R

RECORD

Cased in., ft.Sand Gas Oil Total Depth

PRODUCTION

1st 24 hrs. Nat. 1st 24 hrs. after shot Gas Cu. Ft.Dry Hole Abandoned

Date

NOV 21 1945 19S. J. LEWIS Scout

KANSAS ~~Kansas~~ Pool Name Stoltenberg
 Map No. 35 Sec. 28 Twp. 16 R. 10W
 Well No. 4 Schroeder

Lion Oil Company

COMPLETED

Contractor

SE NE NW


E. 1/831
SECTION PLAT

990 Ft. from N. Line

_____ Ft. from S. Line

330 Ft. from E. Line

_____ Ft. from W. Line

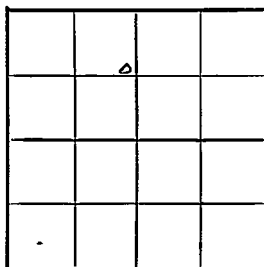

Ellsworth County

Location _____

Rig up _____

Drilling and Remarks:

Ref 3304

5" 3305

Range 2305

42 0/16

RECORD

Cased _____ in., _____ ft.

Sand _____

Gas _____

Oil _____

Total Depth 3331

PRODUCTION

1st 24 hrs. Nat. _____

1st 24 hrs. after shot _____

Gas _____ Cu. Ft.

Dry Hole _____

Abandoned _____

Date

JAN 9 1946 19

S. J. LEWIS

Scout