

Cowley.

KANSAS

SECTION 19 TOWNSHIP 32 RANGE 7 E

WELL NO. #1 Ledgerwood

COMPANY Mallonee Drlg.

NORTH

						0	

WEST

EAST

SOUTH

Cowley

KANSAS

SEC. 19	TWP. 32	R. 7E
------------	------------	----------

WELL NO. #1 Ledgerwood FARM

COMPANY Mallonee Drlg.

CONTRACTOR Co. Tools

WILDCAT


_____ Ft. from N. Line

_____ Ft. from S. Line

_____ Ft. from E. Line

_____ Ft. from W. Line

SW NE NE

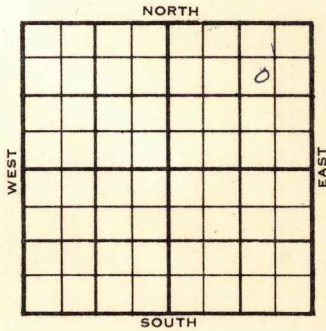

1955	ELEVATION 1247'	REPORT
------	--------------------	--------

11-30 Comm. 11-23-55
 8" @ 108
 Drlg. 1840

12-7 D & A
 Log tops:
 Stal 1722
 Layton 2075
 KC 2257
 Sh. 2616
 lm. 2877
 TD 2913'

ABANDONED

County Cowley Elev. _____
 Sec. 19 Twp. 32 Rge. 7E
 Company Mallonee Drlg.
 Farm Name Ledgerwood No. 1

TOPS	DEPTH	LOG	DATUM	Loc. in Sec.
Anh.				SW NE NE
TP.				
H.				
Tr.				
Dg.				
BL.				
L.				Geol. _____
K.C.				Contr. _____
B.K.C.				
Ce.				Co. tools
C.				
M.				Pool
M.				Wildcat
K.				
Mz.				
Mq.				
V.				
S.				
S.				
A.				
R.				
PE.				
G.				
T.D.				



Date Comm. 11-23-55
8" @ 108 drlg. 1840

Co.
 Lse.
 No.
 Sec.
 T.
 R.

County Conley Elev. 1247
 Sec. 19 Twp. 32 Rge. 7E
 Company Mallonee Drlg.
 Farm Name Ledgerwood No. 1

TOPS	DEPTH	LOG	DATUM
Anh.			
TP.			
H. <u>stal</u>		<u>1722</u>	<u>475</u>
Tr. <u>Dayton</u>		<u>2075</u>	<u>828</u>
Dg.			
BL.			
L.			
K.C.		<u>2257</u>	<u>1010</u>
B.K.C.			
Ce. <u>sh</u>		<u>2616</u>	<u>1369</u>
C. <u>lsn</u>		<u>2877</u>	<u>1630</u>
M.			
M.			
K.			
Mz.			
Me.			
V.			
S.			
S.			
A.			
R.			
Pe.			
G.			
T.D.	<u>2913</u>		

Loc. in Sec. SW NE NE

Geol. _____

Contr. Co. tools

Pool Wildcat



ABANDONED

Date Comm. 11-23-55 DEC 7 1955

8" @ 108

D & A

Co.
Lse.
No.
Sec.
T.
R.