

KANSAS


Cowley

Form 51—5M—11-38—Palace

Section 16 Township 32 Range 5-E

Well No. #2 Gardner "A"

Company Sinclair Prairie

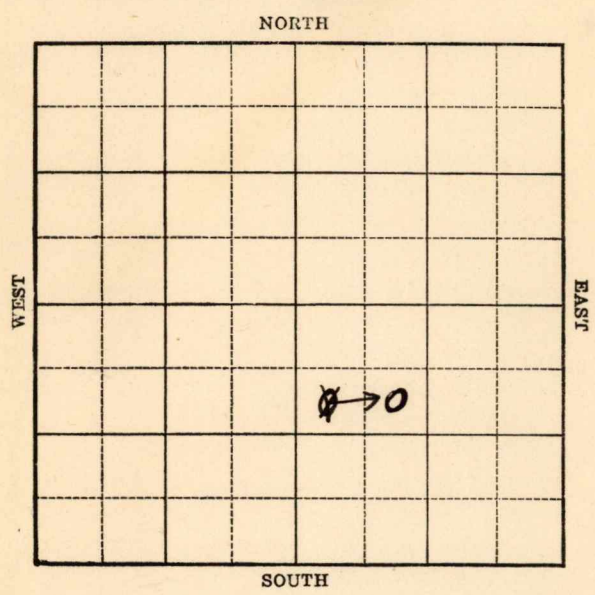

1939

10/4

Bart. 3049'

6" - 3053'

T.D. 3101'

Shot 60 qts. 3081-3100'

Potential 543 bbls., pump.

COMPLETED

Map No. 2 Sec. 16 Twp. 32 R. 5EWell No. 2 Gardner "A"Sinclair Prairie

Company _____

Contractor _____

COMPLETED

SECTION PLAT

990 SE NW SE
Ft. from N. Line

_____ Ft. from S. Line

_____ Ft. from E. Line

990 Ft. from W. Line

FROG HOLLOW POOL

Location _____

Rig up _____

Drilling and Remarks:

*Bar 8048**6" @ 3053**Shot 609 to 3081*
*3100**Pump 5438*

RECORD

Cased _____ in., _____ ft.

Sand _____

Gas _____

Oil _____

Total Depth 3101

PRODUCTION

1st 24 hrs. Nat. _____

1st 24 hrs. after shot _____

Gas _____ Cu. Ft.

Dry Hole _____

Abandoned _____

Date

OCT 4 1939

19

S. J. LEWIS

Scout

Cowley

KANSAS

Map No. 2 Sec. 16 Twp. 32 R. 5E

Well No. 2 Gardner "A"

Sinclair Prairie

Company

CORRECTION

Contractor

SECTION PLAT

SE NW SE

990 Ft. from N. Line

_____ Ft. from S. Line

_____ Ft. from E. Line

990 Ft. from W. Line

FROG HOLLOW POOL

Location X

Rig up _____

Drilling and Remarks:

RECORD

Cased _____ in., _____ ft.

Sand _____

Gas _____

Oil _____

Total Depth _____

PRODUCTION

1st 24 hrs. Nat. _____

1st 24 hrs. after shot _____

Gas _____ Cu. Ft.

Dry Hole _____

Abandoned _____

Date

JUL 19 1939

19

Scout

Map No. _____ Sec. 16 Twp. 32 R. 5E

Well No. 2 Gardner "A"

Sinclair Prairie

Company _____

Contractor _____

FIRST REPORT

SECTION PLAT

SE NW SE

990 Ft. from N. Line

_____ Ft. from S. Line

_____ Ft. from E. Line

330 Ft. from W. Line

FROG HOLLOW POOL

Location X

Rig up _____

Drilling and Remarks:

RECORD

Cased _____ in., _____ ft.

Sand _____

Gas _____

Oil _____

Total Depth _____

PRODUCTION

1st 24 hrs. Nat. _____

1st 24 hrs. after shot _____

Gas _____ Cu. Ft.

Dry Hole _____

Abandoned _____

Date

JUL 12 1939

19


Scout

We show #1 here.

28-1M Bk-2-22

Company
Contractor

SECTION PLAT

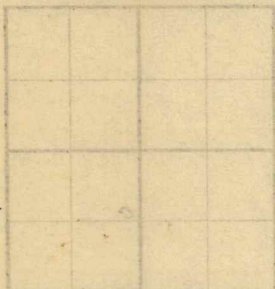

SE NW 35
990 Ft. from N. line
Ft. from S. line
Ft. from E. line
830 Ft. from W. line

FROG HOLLOW POOL

RECORD

Carded in
Sand
Gas
Oil

Location X

Rig up
Drilling and Remarks:

Misc Small Maps

Cards

Tracing

France Map

Scarborough Map

Moody Map

Geological Dept.

Moody Plat Book

Date