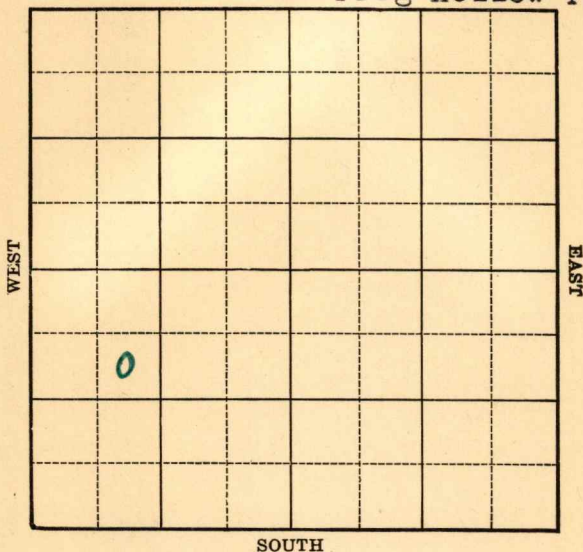


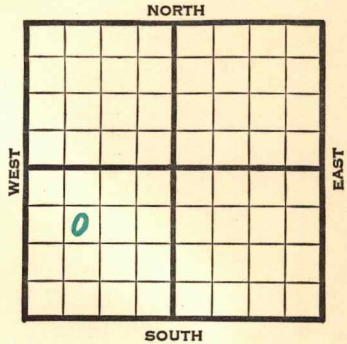
Section 16 Township 32 Range 5-EWell No. 1 ~~Millan~~ MillerCompany Arthur Brewer

NORTH Frog Hollow Pool



Sec. 16 Twp. 32 R. 5-EWell No. #1 ~~Millan~~ Miller FarmArthur Brewer Company

(Frog Hollow)

990 Ft. from N. Line Ft. from S. Line Ft. from E. Line990 Ft. from W. Line

Elev. 1312

1941	REPORT
2/19	Cable.
2/27	Rigging up.
3/6	20" - 35' 15" - 435'
	S/gas 480' Drlg. 970'
3/13	12" - 1124' 1680' run 10".
3/20	10" - 1755' Drlg. 2155'
3/27	Bart. 3036-39' T.D. 6" - 3018'
	WOC.
4/2	T.D. 3078' Shot 100 qts
	3048-74' C.O.
4/10	" " "
4/16	Bart. 3036'
	T.D. 3078'
	Shot 100 qts.
	173 bbls. oil.
	COMPLETED

Cowley

KANSAS

Map No. 2 Sec. 16 Twp. 32 R. 5EWell No. 1 MillanArthur Brewer

Company

FIRST REPORT

Contractor

SECTION PLAT

SE NW SW

990 Ft. from N. Line Ft. from S. Line Ft. from E. Line990 Ft. from W. Line

FROG HOLLOW POOL

Location Rig up

Drilling and Remarks:

Cable

RECORDCased in., ft.Sand Gas Oil Total Depth **PRODUCTION**1st 24 hrs. Nat. 1st 24 hrs. after shot Gas Cu. Ft.Dry Hole Abandoned

Date

FEB 19 1941

S. J. LEWIS

19

Scout

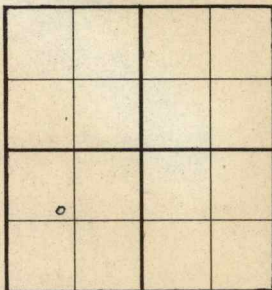
Map No. 2 Sec. 16 Twp. 32 R. 5EWell No. 1 MillerArthur Brewer

Company

CORRECTION

Contractor

SECTION PLAT

SE NW SW
990 Ft. from N. Line Ft. from S. Line Ft. from E. Line990 Ft. from W. Line

FROG HOLLOW POOL

Location Rig up

Drilling and Remarks:

Reported as

#1 Millan

RECORD

Cased in., ft.Sand Gas Oil Total Depth

PRODUCTION

1st 24 hrs. Nat. 1st 24 hrs. after shot Gas Cu. Ft.Dry Hole Abandoned

Date

MAR 12 1941 19

S. J. LEWIS

Scout

Map No. 2 Sec. 16 Twp. 32 R. 5EWell No. 1 MillerArthur Brewer Company

Contractor

COMPLETED

SE NW SW

990 Ft. from N. Line Ft. from S. Line Ft. from E. Line990 Ft. from W. Line

SECTION PLAT

FROG HOLLOW POOL

Location Rig up

Drilling and Remarks:

100 gts.173 bbls

RECORD

Cased in., ft.Sand Bart 3036Gas Oil Total Depth 3078

PRODUCTION

1st 24 hrs. Nat. 1st 24 hrs. after shot Gas Cu. Ft.Dry Hole Abandoned

Date

APR 16 1941

19

S. J. LEWIS

Scout