


KANSAS

Map No. _____ Sec. 18 Twp. 32 R. 6 E

Well No. 1 - Cook Farm

Lewis Gas Products Company

NORTH

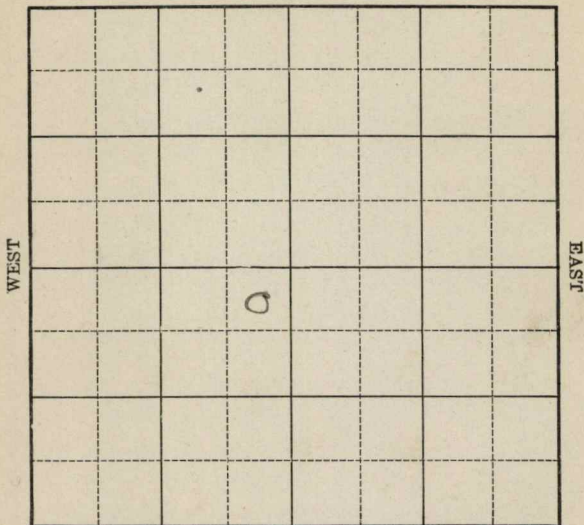

SOUTH

Location _____

Drilling Remarks _____

RECORD

Cased _____ in. _____ ft.

Sand _____

Gas _____

Oil _____

Total Depth _____

Rig Up _____

Drilling Remarks _____

PRODUCTION

1st 24 hrs. Nat. _____

1st 24 hrs. after shot _____

Gas _____ cu. ft.

Dry Hole _____

Abandoned _____

Map No. **KANSAS** Sec. 18 Twp. 32 R. 6 EWell No. 1-Cook FarmLewis Gas Products Company

NORTH

330 Ft. from N. Line

_____ Ft. from S. Line

330 Ft. from E. Line

_____ Ft. from W. Line

WEST

EAST

SOUTH

1928

Date

REPORT

4/5	Rig up
4/12	Rigging up-
4/19	Spudding
4/26	Drlg 325
5/3	" 1630
5/10	" 2037
5/18	" 2250
5/24	Top Chat 3031-36 small show
	Top line 3036 - Ad. 3041-53
	drilling 3097-
5/31	Chat 3031-36 - show
	Top line 3036
	sand 3041-53 dry
	W. & A. 3140'

Cawley

E

2 KANSAS
Map No. Sec. 18 Twp. 32 R. 6
Well No. 1 Cook
Lewis Gas Products Company

Contractor

FIRST REPORTS

SECTION PLAT

330 Ft. from N. Line
Ft. from S. Line
330 Ft. from E. Line
Ft. from W. Line

	o		

Location
Rig up ✓
Drilling and Remarks:

RECORD

Cased in., ft.
Sand
Gas
Oil
Total Depth

PRODUCTION

1st 24 hrs. Nat.
1st 24 hrs. after shot
Gas Cu. Ft.
Dry Hole
Abandoned

Date

APR 5 1928

192

CHAS. L. SHERWOOD

Scout

2 **KANSAS** 18 32 6
 MAP NO. SEC. TWP. R.

WELL NO. 1
 Lewis Gas Products COMPANY

CONTRACTOR

SECTION PLAT

COMPLETED

330 Ft. FROM N. LINE

Ft. FROM S. LINE

330 Ft. FROM E. LINE

Ft. FROM W. LINE

ABANDONED

	0		

LOCATION

RIG UP

DRILLING AND REMARKS:

Chat 3031-36' show

TL 3036'

hard 3041-53' dry

Dga 3140'

RECORD

CASED IN. FT.

SAND

GAS

OIL

TOTAL DEPTH 3140

PRODUCTION

1ST 24 HRS. NAT.

1ST 24 HRS. AFTER SHOT

GAS Cu. Ft.

DRY HOLE ✓

ABANDONED ✓

DATE

MAY 31 1928

192

CHAS. L. SHERWOOD

SCOUT