


Section 18 Township 32 Range 6E

Well No. 2 Bynum

Company K. T. Weidemann

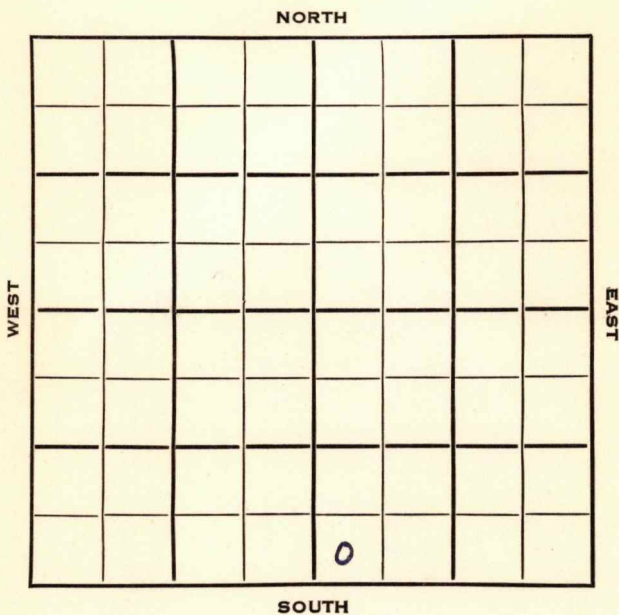

Cowley KANSAS

SEC. 18 TWP. 32 R. 6E ✓

WELL NO. 2 Bynum FARM

COMPANY K. T. Weidemann

CONTRACTOR Weidemann


Wildcat

\_\_\_\_\_ Ft. from N. Line

330 \_\_\_\_\_ Ft. from S. Line

\_\_\_\_\_ Ft. from E. Line

330 \_\_\_\_\_ Ft. from W. Line

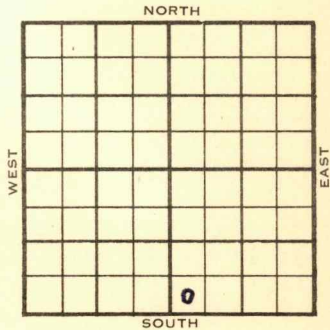

SW SW SE

1954 ELEVATION 1312' REPORT

2/10  
4/28

RUR  
Spud 2-8-54 D & A TD 2412  
8" @ 115 Lans. 2275 TD 2412  
7" @ 2409 CO to 2412  
D & A

**ABANDONED**



