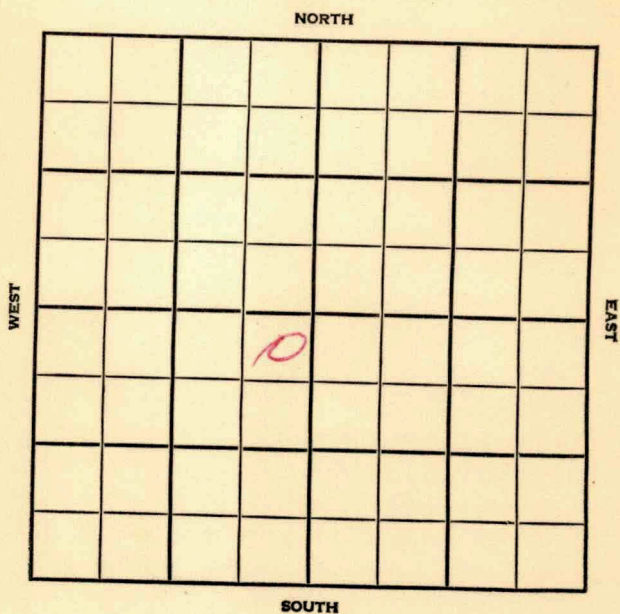


Section 19 Township 32 Range 6EWell No. #1 CranstonCompany Petroleum Inc.

Cowley

KANSAS

SEC.

19

TWP.

32

R.

6E

WELL NO.

#1 Cranston

FARM

COMPANY

Petroleum Inc.

CONTRACTOR

Garvey

Turner


_____ FT. FROM N. LINE

_____ FT. FROM S. LINE

_____ FT. FROM E. LINE

_____ FT. FROM W. LINE

NE NE SW

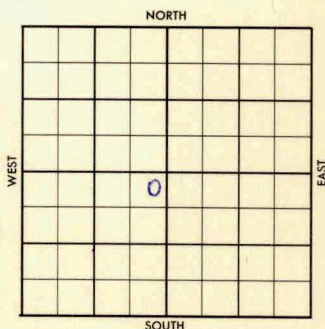

1956

ELEVATION

1307 RB

REPORT

6-6

Comm. 6-2-56

8" @ 110

Drlg. 1500

6-13

DST 238--2420, 1 hr. 360 M., ~~900~~
900' msw

B 780#

DST 3049-3102, op 1 hr. 20' M.

B 60#

D & A

Tp. 1179', H. 1566', Dg. 1625',
 Stat. 1898', L. 2059', Lay 2275',
 K.C. 2475', Clev. 2596', Ft. Sc. 2764',
 Cher. 2795', Burg. 3049',
 M.A. 3052'.

TD 3102'

ABANDONED

County Cowley Elev. 1302 RB
 Sec. 19 Twp. 32 Rge. 6E
 Company Petroleum Inc.
 Farm Name Cranston No. 1

TOPS	DEPTH	LOG	DATUM	Loc. in Sec.
Anh.				NE NE SW
Tp.	1179			
H.	1566			
Tr.				
Dg.	1625			
BL. <u>5th</u>	1898			
L.	2059			
K.C. <u>Ray</u>	2275			Geol.
B.K.C. <u>KS</u>	2475			Contr.
Ce. <u>Clear</u>	3596			Garvey
C. <u>Et Sc.</u>	2764			
M. <u>Cher.</u>	2795			
M. <u>Bur.</u>	3049			Pool
K. <u>MA</u>	3052			Turner
Mz.				
Mo.				
V.				
S.				
S.				
A.				
R.				
PE.				
G.				
T.D.	3102			

ABANDONED
 JUN 13 '56

Date Comm. 6-2-56
 8" @ 110 drlg. 1500 JUN 13 '56

DST 2380-2420/1m/ 360' m/ 900' msw
 B 780'

DST 3049-3102, OP 1m/ 20' m,
 B 60' m

D & A

County Cowley Elev. _____
 Sec. 19 Twp. 32 Rge. 6E
 Company Petroleum Inc.
 Farm Name Cranston No. 1

TOPS	DEPTH	LOG	DATUM	Loc. in Sec.
Anh.				NE NE SW
Tp.				
H.				
Tr.				
Dg.				
Bl.				
L.				Geol. _____
M.C.				Contr. _____
B.K.C.				
Ce.				Garvey
C.				Pool
M.				Turner
M.				
K.				
Mz.				
Mq.				
V.				
S.				
S.				
A.				
R.				
PE.				
G.				
T.D.				

FIRST REPORT
 JUN 6 '55

Date Comm. 6-2-56
8" @ 110 drlg. 1500

Co.

Lse.

No.

Sec.

T.

R.

JUN 1 1956

R. G.