

KANSAS

Ellsworth


Form 51-5M-7-39-Plate

Section 30 Township 16 Range 10-W

Well No. #1 Lillie

Company Russell Moore et al

NORTH Stoltenberg Pool

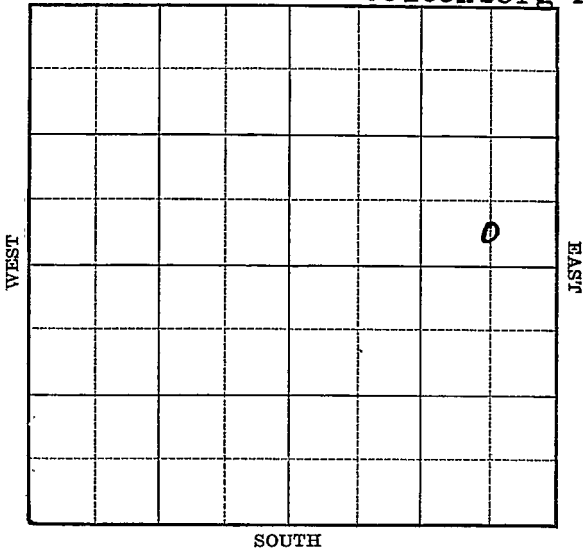

8

Sec. 30 Twp. 16 R. 10-W

Well No. #1 Lillie Farm

Russell Moore et al Company

(Stoltenberg)


_____ Ft. from N. Line

330 Ft. from S. Line

660 Ft. from E. Line

_____ Ft. from W. Line

Elev. 1858

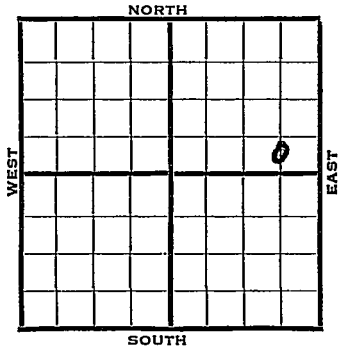

1940	REPORT
4/17	Cable rig.
4/25	15" - 206'
	Drlg. 230'
5/2	Drlg. 640'
5/9	12" - 651' Anhy 641'
	Drlg. 1440'
5/16	Ft. Riley 1595' Florence 1690'
	Neva 1900' 10" - 1935' C.O.
5/23	10" - 2073' Drlg. 2120'
5/29	Drlg. 2790'
6/6	Lans. 3026' S.O. 3040'
	8" - 3114' Drlg. 3215'
6/12	Arb. 3364' (Corrected)
	T.D. 3406'
	H.F.W.
	ABANDONED

Map No. 55 Sec. 30 Twp. 16 R. 10W

Well No. 1 Lillie

Russell Moore et al Company

Contractor

FIRST REPORT

SECTION PLAT

C S L SE NE

_____ Ft. from N. Line

330 Ft. from S. Line

660 Ft. from E. Line

_____ Ft. from W. Line

STOLTENBERG POOL

Location _____

Rig up _____

Drilling and Remarks:

Cable Rig

RECORD

Cased _____ in., _____ ft.

Sand _____

Gas _____

Oil _____

Total Depth _____

PRODUCTION

1st 24 hrs. Nat. _____

1st 24 hrs. after shot _____

Gas _____ Cu. Ft.

Dry Hole _____

Abandoned _____

Date

APR 17 1940 19

S. J. LEWIS Scout

Map No. 55 Sec. 30 Twp. 16 R. 10WWell No. 1 LillieRussell Moore etal Company

Contractor

ABANDONED

C S L SE NE

 Ft. from N. Line330 Ft. from S. Line660 Ft. from E. Line Ft. from W. Line

SECTION PLAT

			o

STOLTENBERG POOL

Location Rig up

Drilling and Remarks:

*see 3364 corrected**HFW.*

RECORD

Cased in., ft.Sand Gas Oil Total Depth 3406

PRODUCTION

1st 24 hrs. Nat. 1st 24 hrs. after shot Gas Cu. Ft.Dry Hole Abandoned

Date

JUN 12 1940 19S. J. LEWIS Scout