

KANSAS


FORM 51 5M 11-44 PETROL

Ellsworth County

Section 32 Township 16 Range 10W

Well No. #1 Novotny

Company M. M. Price et al

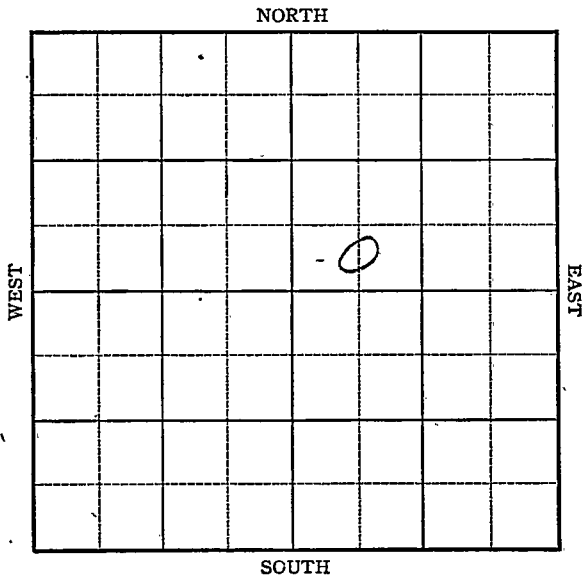

KANSAS

Ellsworth County

Sec. 32 Twp. 16 R. 10W

Well No. #1 Novotny Farm
M. M. Price et al Company


Wildcat

_____ Ft. from N. Line

330 Ft. from S. Line

_____ Ft. from E. Line

660 Ft. from W. Line

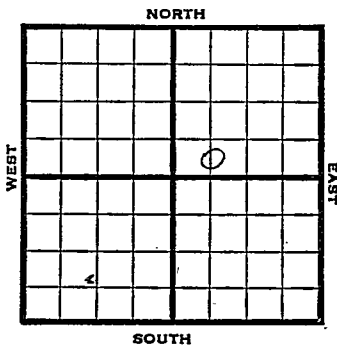

CSL SW NE

1946 Elev. 1864' REPORT

2/13	Rig
2/21	"
2/28	"
3/7	"
3/14	196' run 12".
3/21	Shut down.
3/28	12" - 196' 450' UR 10".
4/4	10" @ 650' drlg.
4/10	Anhy 648 Drlg 1580
4/15	1950 SD
4/23	" "
5/1	" "
5/7-	" "
5/14	" "
5/21	" "
5/29	" "
6/5	" "
6/12	" "
6/18	" "
6/26	" "
7/3	" "
7/9	" "
7/16	" "
7/23	" "
7/30	" "
8/6	8" @ 1936-1950 CO

OVER

1946

8/13 Drlg 2435'
8/20 Drlg 2725'
8/27 Drlg 2980'
6" @ 2440'
9/5 Lans 2996'
3074 run csg
9/10 5" @ 3074'
Drlg 3245'
9/18 Arb 3344'
3374 SD
9/24 " "
10/1 5" @ 3396 WOC
10/8 " "
10/15 " "
10/22 " "
10/29 " "
11/7 " "
11/12 " "
11/20 " "
11/27 " "
12/3 " "
12/10 " "
12/17 " "

1947

1/4 5" @ 3396' WOC
1/8 " "
1/15 " "
1/21 " "
2/30 " "
2/5 " "
2/12 " "
2/19 " "
2/26 " "

3/4	TD 3396'	
	PB 3390'	
3/11	"	"
3/18	SD	
3/25	PB 3388'	
	500 Acid	
4/2	"	"
4/9	"	"
4/15	"	"
4/23	"	"
4/29	"	"
5/7	"	"
5/13	"	"
5/20	"	"
5/27	"	"
6/3	"	"
6/10	"XX"	
6/17	"	"
6/24	"	"
7/2	Arb. 3337'	
	TD 3396'	

ABANDONED

