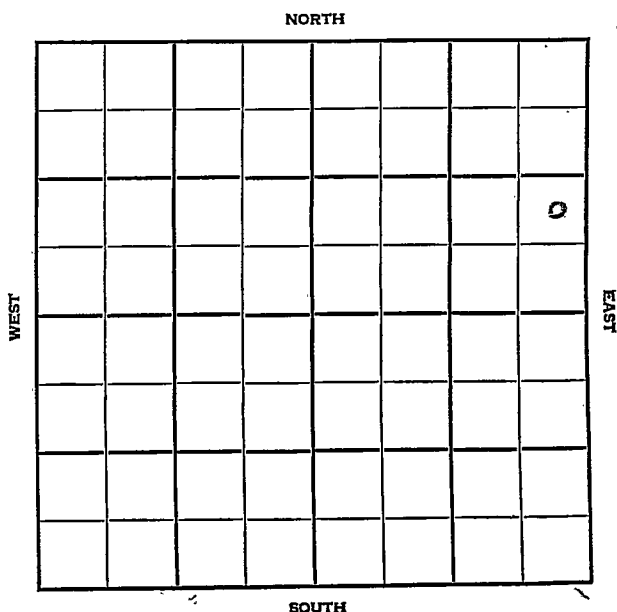


Section 29 Township 16 Range 10WWell No. #1 Johansen (Johansen)Company Duke Drlg.

Ellsworth

KANSAS

SEC.	TWP.	R.
29	16	10W

WELL NO.

1 Johansen

FARM

COMPANY

Duke Drlg.

CONTRACTOR

Co. Tools

Stoltenberg pool


Ft. from N. Line

990' Ft. from S. Line

330' Ft. from E. Line

Ft. from W. Line

NE SE NE

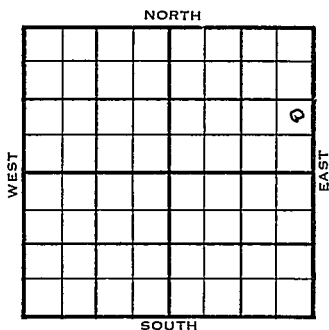

	ELEVATION	REPORT
1955	1830'	

5/25 Spud 5-16-55
 8" @ 290/160
 Heeb 2858, Tor 2882, Br Lima 2966
 KC 2981
 Drlg 3109'

6/1 D&A

Tops:	Depth	Datum
H.	2858	1028
Tr.	2882	1052
BL	2966	1136
KC	2981	1151
A.	3308	1478
TD:	3322	

ABANDONED

County Ellsworth Elev. 1830Sec. 29 Twp. 16 Rge. 10WCompany Duke Drlg.Farm Name Johansen No. 1

TOPS	DEPTH	LOG	DATUM	Loc. in Sec.
Anh.				NE SE NE
Tp.				
H.	<u>2858</u>		<u>1028</u>	
Tr.	<u>2882</u>		<u>1052</u>	
Dg.				
BL.	<u>2966</u>		<u>1136</u>	
L.				
K.C.	<u>2981</u>		<u>1151</u>	Geol.
B.K.C.				Contr.
Ce.				Co. tools
C.				
M.				Pool
M.				Stoltenberg
K.				
Mz.				
Me.				
V.				
S.				
S.				
A	<u>3308</u>		<u>1478</u>	
R.				
PE.				
G.				
T.D.	<u>3322</u>			

Date Comm. 5-16-55

JUN 1 1955

8" @ 290/160

D & A

Kraft-Person