


Section 24 Township 25 Range 4E

Well No. #6 Cogswell

Company Franco Central

Miscellaneous

NORTH

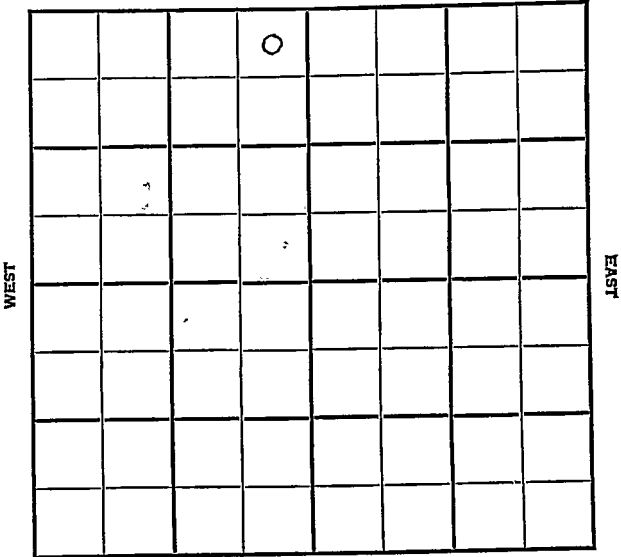

SOUTH

KANSAS

Butler

Sec. 24 Twp. 25 R. 4E

Well No. #6 Cogswell Farm

Franco Central Company


Miscellaneous

330' Ft. from N. Line

_____ Ft. from S. Line

330' Ft. from E. Line

_____ Ft. from W. Line

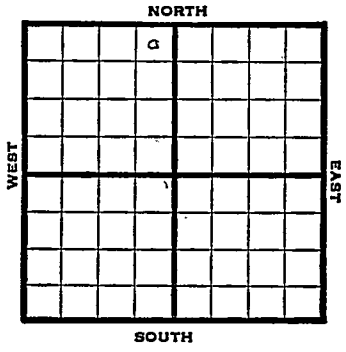

NE NW

1948 Elev. 1412' REPORT

- 2/25 Location
- 3/3 "
- 3/10 "
- 3/17 "
- 3/24 "
- 3/31 "
- 4/7 15" @ 235'
Drlg. 590'
- 4/14 Drlg. 1400'
- 4/21 10" @ 1697'
Lansing 1855'
KC 2135'
Drlg. 185'
- 4/28 8" @ 2377'
Mississippi 2580'
TD 2584'
7" @ 2580'
RUST
- 5/6 Miss 2580'
7" @ 2580'
Pump 50 oil Pot.
Gr. 38°
TD 2602'

COMPLETED

Map No. _____ Sec. 24 Twp. 25 R. 4E

Well No. 6 Cogswell

Franco Central Company

FIRST REPORT

Contractor _____

NE NW

SECTION PLAT

330 Ft. from N. Line

	o		

_____ Ft. from S. Line

330 Ft. from E. Line

_____ Ft. from W. Line

Butler County

RECORD

Location X

Cased _____ in., _____ ft.

Rig up _____

Sand _____

Drilling and Remarks:

Gas _____

Oil _____

Total Depth _____

PRODUCTION

1st 24 hrs. Nat. _____

1st 24 hrs. after shot _____

Gas _____ Cu. Ft.

Dry Hole _____

Abandoned _____

Date

FEB 25 1948

19

S. J. LEWIS

Scout

Map No. 14 Sec. 24 Twp. 25 R. 4E

Well No. 6 Cogswell

Franco Central Company

COMPLETE

Contractor

NE NW

E. 1. 1412
SECTION PLAT

330 Ft. from N. Line

 Ft. from S. Line

330 Ft. from E. Line

 Ft. from W. Line

	6		

Butler County

Location

Rig up

Drilling and Remarks:

Mile 2580
7" @ 2580
Pump 50 oil
28-6-48

RECORD

Cased in., ft.

Sand

Gas

Oil

Total Depth 2602

PRODUCTION

1st 24 hrs. Nat.

1st 24 hrs. after shot

Gas Cu. Ft.

Dry Hole

Abandoned

Date

MAY 5 1948 19

S. J. LEWIS Scout