


KANSAS

Butler

Section 24 Township 25 Range 4E

Well No. #2 "28-D" Jackson "A"

Company Darling et al

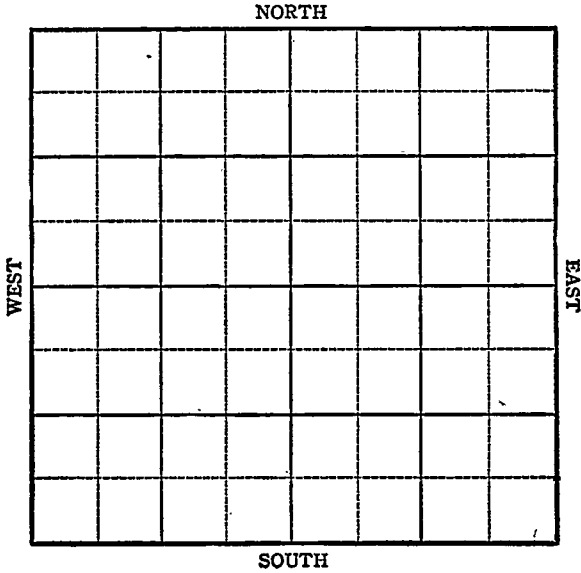

**KANSAS**

Butler

Sec. 24 Twp. 25 R. 4E

Well No. #2 #28-B "Jackson" "A" Farm

Darling et al Company


Miscellaneous

990 Ft. from N. Line

Ft. from S. Line

990 Ft. from E. Line

Ft. from W. Line

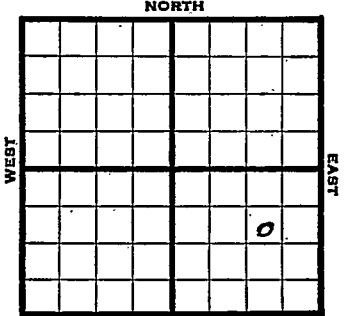

SW NE SE Elev. 1422

1944

REPORT

- 8/23 Machine
- 8/30 "
- 9/8 13" @ 240 Drlg. 400
- 9/13 Drlg. 926
- 9/21 12" @ 940 Drlg. 1555
- 9/28 10" @ 1750  
KC 2110  
Drlg. 2210
- 10/4 Chat 2530 TD  
Run 5"
- 10/11 5" @ 2530 TD 2603  
60 qts CO
- 10/18 " " " " " "
- 10/25 Chat 2530  
5" @ 2530  
60 qts  
Pump 25 Pot.  
TD 2603  
Grav. 37.1

KANSAS

Pool Name Miscellaneous

Map No. 14 Sec. 24 Twp. 25 R. 4E

Well No. 2 "28-D" Jackson "A"

Darling etal. Company

**FIRST REPORT**

Contractor

SW NE SE

**SECTION PLAT**

990 Ft. from N. Line

\_\_\_\_\_ Ft. from S. Line

990 Ft. from E. Line

\_\_\_\_\_ Ft. from W. Line

			o

Butler County

Location \_\_\_\_\_

Rig up \_\_\_\_\_

Drilling and Remarks:

Machine

**RECORD**

Cased \_\_\_\_\_ in., \_\_\_\_\_ ft.

Sand \_\_\_\_\_

Gas \_\_\_\_\_

Oil \_\_\_\_\_

Total Depth \_\_\_\_\_

**PRODUCTION**

1st 24 hrs. Nat. \_\_\_\_\_

1st 24 hrs. after shot \_\_\_\_\_

Gas \_\_\_\_\_ Cu. Ft.

Dry Hole \_\_\_\_\_

Abandoned \_\_\_\_\_

Date

AUG 23 1944 19

S. J. LEWIS Scout

Pool Name Miscellaneous

**KANSAS**

Map No. 14 Sec. 24 Twp. 25 R. 4E

Well No. 2 "28D" Jackson "A"

Darling et al. Company

**COMPLETED** Contractor

SW NE SE

**SECTION PLAT**

990 Ft. from N. Line

\_\_\_\_\_ Ft. from S. Line

990 Ft. from E. Line

\_\_\_\_\_ Ft. from W. Line

			<i>b</i>

**Butler** County

**RECORD**

Location \_\_\_\_\_

Rig up \_\_\_\_\_

Drilling and Remarks:

*Cha 2530*

*5' @ 2530*

*609 ft.*

*Pump 2530*

*372 90*

Cased \_\_\_\_\_ in., \_\_\_\_\_ ft.

Sand \_\_\_\_\_

Gas \_\_\_\_\_

Oil \_\_\_\_\_

Total Depth 2609

**PRODUCTION**

1st 24 hrs. Nat. \_\_\_\_\_

1st 24 hrs. after shot \_\_\_\_\_

Gas \_\_\_\_\_ Cu. Ft.

Dry Hole \_\_\_\_\_

Abandoned \_\_\_\_\_

Date

OCT 25 1944 19 \_\_\_\_\_

S. J. LEWIS Scout