

# KANSAS

Form 51-5M-7-39-Palace


## Ellsworth

Section 32 Township 16 Range 10-W

Well No. #1 Novotony

Company Sharon Drilling et al

NORTH Stoltenberg Pool

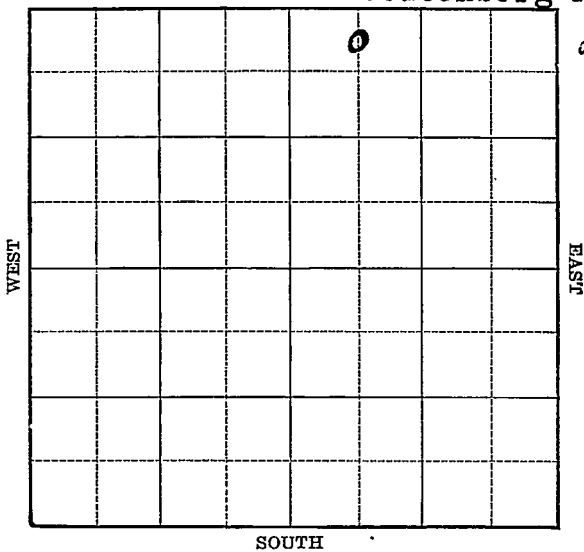

Sec. 32 Twp. 16 R. 10-W

Well No. #1 Novotony Farm

Sharon Drilling et al Company

(Stoltenberg)


330 Ft. from N. Line

\_\_\_\_\_ Ft. from S. Line

\_\_\_\_\_ Ft. from E. Line

660 Ft. from W. Line

Elev. 1832

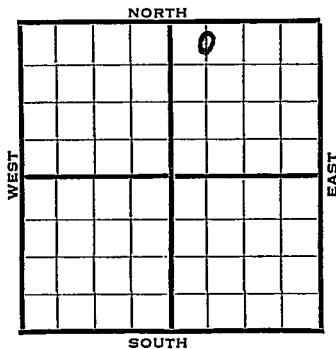

1940	REPORT
4/17	Location
4/25	8" - 140' Anhy 600'
	Drlg. 665'
5/2	T.D. 1950' Fsg.
5/9	Lost hole. Skid 33' north
	8" - 140' Drlg. 1385'
5/16	Lans. 2989' Drlg. 3007'
5/23	Arb. 3292' T.D. 3308'
	5" - 3294' RUST.
5/29	T.D. 3318½' 1000 acid.
	400' oil 8 hours.
6/5	Arb. 3292'
	5" - 3294'
	T.D. 3318½'
	12 qts. shot 3302-14'
	3000 acid.
	Water.
	<b>ABANDONED</b>

Map No. 55 Sec. 32 Twp. 16 R. 10WWell No. 1 NovotonySharon Drilling etal Company

Contractor

**FIRST REPORT**

C N L NW NE

330 Ft. from N. Line

\_\_\_\_\_ Ft. from S. Line

\_\_\_\_\_ Ft. from E. Line

660 Ft. from W. Line**STOLTENBERG POOL****SECTION PLAT**


Location X

Rig up \_\_\_\_\_

Drilling and Remarks: \_\_\_\_\_

**RECORD**

Cased \_\_\_\_\_ in., \_\_\_\_\_ ft.

Sand \_\_\_\_\_

Gas \_\_\_\_\_

Oil \_\_\_\_\_

Total Depth \_\_\_\_\_

**PRODUCTION**

1st 24 hrs. Nat. \_\_\_\_\_

1st 24 hrs. after shot \_\_\_\_\_

Gas \_\_\_\_\_ Cu. Ft.

Dry Hole \_\_\_\_\_

Abandoned \_\_\_\_\_

Date

APR 17 1940 19S. J. LEWIS Scout

Map No. 55 Sec. 32 Twp. 16 R. 10W

Well No. 1 Novotony

Sharon Drilling etal Company

Contractor

**ABANDONED**  
C N L NW NE

**SECTION PLAT**

330 Ft. from N. Line

\_\_\_\_\_ Ft. from S. Line

\_\_\_\_\_ Ft. from E. Line

660 Ft. from W. Line

		o	

**STOLTENBERG POOL**

Location \_\_\_\_\_

Rig up \_\_\_\_\_

Drilling and Remarks:

*Cor & 3292.*

*5" C 3294*

*12 qt ash & 3302-14*

*3500 acid*

*Water.*

**RECORD**

Cased \_\_\_\_\_ in., \_\_\_\_\_ ft.

Sand \_\_\_\_\_

Gas \_\_\_\_\_

Oil \_\_\_\_\_

Total Depth 3318 1/2

**PRODUCTION**

1st 24 hrs. Nat. \_\_\_\_\_

1st 24 hrs. after shot \_\_\_\_\_

Gas \_\_\_\_\_ Cu. Ft.

Dry Hole \_\_\_\_\_

Abandoned \_\_\_\_\_

Date

JUN 5 1940 19

S. J. LEWIS Scout