
FORM 51 25M 3-49 PETROL Ellsworth KANSAS

Section 33 Township 16 Range 10W

Well No. #5 Horst "B"

Company Sohio

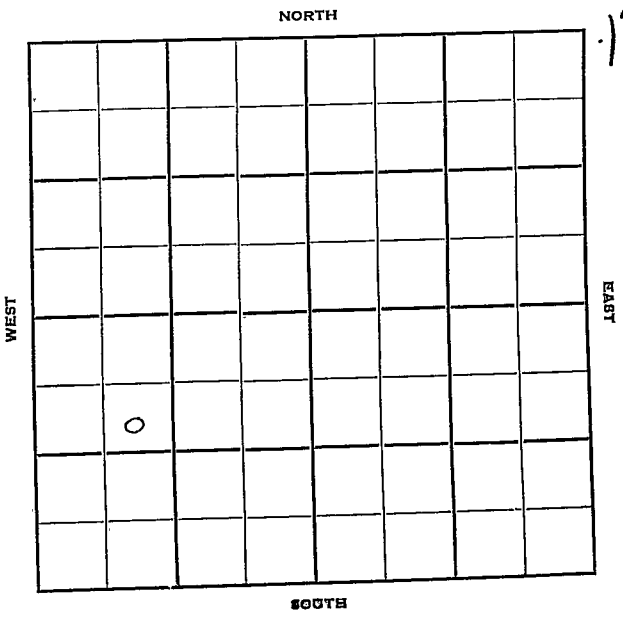

12

FORM 252-B
10M 11-50 PETROL

Ellsworth

KANSAS

Sec. 33 Twp. 16 R. 10 W

Well No. # 5 Horst "B" Farm

Sohio Company

Duke & Woods Contractor

Stoltenberg Pool


990 Ft. from N. Line

Ft. from S. Line

Ft. from E. Line

990 Ft. from W. Line

SE NW SW

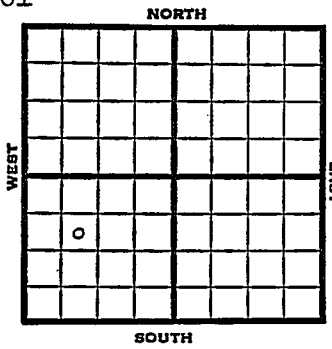

1951	Elev. 1818' REPORT
8/15	Spud 8-7-51 8" @ 311 Drlg. 2640'
10/3	Spud 8-7-51 Oil well TD 3299' 8" @ 311 Heeb 2830' Lans. 2937' DST 2963-73 open 1 hr. rec 28' mud & SW DST 2973-93 open 1 hr. rec 86' SO & GCM DST 2998-3011 open ½ hr. rec 85' HO & GCM Arb. 3272' TD 3285' 5" @ 3275' 2 GOPH 500 A 8 GOPH DD 3292' 21 GOPH 1000 A 1½ BOPH DD 3299' 1000 A S/8 BOPH Comp. 140 BOPD COMPLETED

FORM 275 FOR SALE BY KANSAS BLUE PRINT CO.


County Ellsworth State Kansas

Sec. 33 (Blk. Twp.) 16 (Sur. Rge.) 10W Map No.

Operator Schio

Well No. 5 Farm Horst "B"

Elev. Location SE NW SW

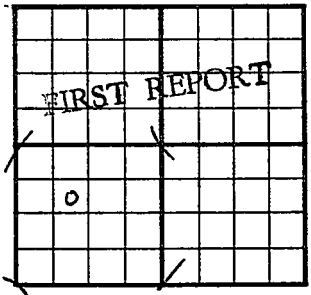

990 Ft. From N Line SW

990 Ft. From W Line Quarter

1st. Report AUG 15 1951

Completion

Remarks

Duke & Woods - Contr.

Spudding Date 8-7-51

Drlg. Data Stoltenberg Pool

8" @ 311 drlg. 2640

J. E. TYRA

FORM 275 FOR SALE BY KANSAS BLUE PRINT CO.


County Ellsworth State Kansas

Sec. 33 (Blk. Twp.) 16 (Sur. Rge.) 10W Map No.

Operator Sohio

Well No. 5 Farm Horst "B"

Elev. 1818 Location SE NW SW

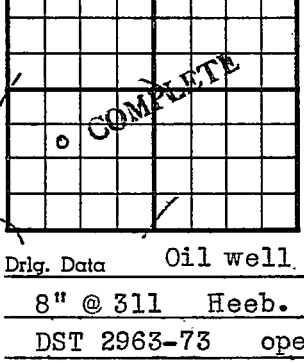

990 Ft. From N Line SW

990 Ft. From W Line Quarter

1st. Report

Completion OCT 3 1951

Remarks Stoltenberg Pool

Duke & Woods - Contr.

Spudding Date 8-7-51

Drlg. Data Oil well TD 3299

8" @ 311 Heeb. 2830 Lans. 2937

DST 2963-73 open 1 hr. Rec. 28' mud & sw

DST 2973-93 open 1 hr. Rec. 86' so & gcm

DST 2998-3011 open ½ hr. Rec. 85' ho & gcm DST 3124-53 open 1 hr. Rec. 20' ho & gcm Arb. 3272 TD 3285 5" @ 3275

2 goph 500 A 8 goph DD 3292

21 goph 1000 A 1½ boph DD 3299

1000 A S/ 8 boph Comp. 140 bopd

J. E. TYRA