

Cowley


KANSAS

SECTION 1 TOWNSHIP 32 RANGE 6E

WELL NO. #6 Youle

COMPANY Blair & Deputy

NORTH

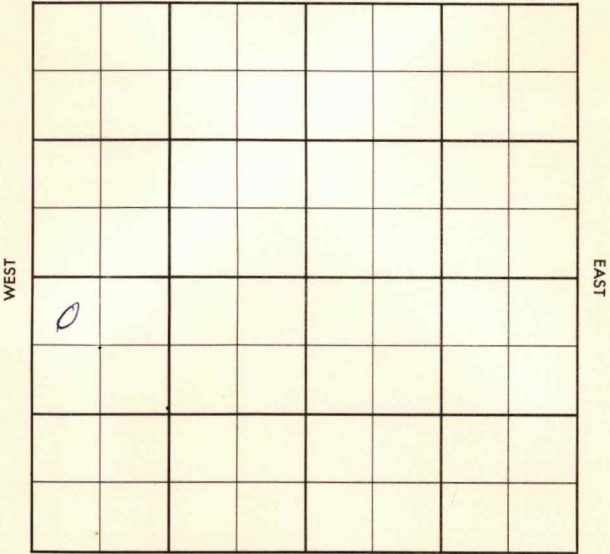

SOUTH

Cowley

KANSAS

SEC.	TWP.	R.
1	32	6E

WELL NO. #6 Youle FARM

COMPANY Blair & Deputy

CONTRACTOR McNab & Lindsay Tools


Estes

_____ FT. FROM N. LINE

_____ FT. FROM S. LINE

_____ FT. FROM E. LINE

_____ FT. FROM W. LINE

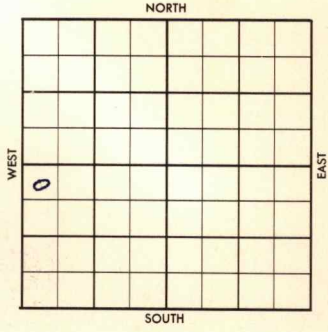

NW NW SW

	ELEVATION	REPORT
1956		

9-12 Location

County Cowley Elev. 1399
 Sec. 1 Twp. 32 Rgs. 6E
 Company Elair & Deputy
 Farm Name Youle No. 6

TOPS	DEPTH	LOG	DATUM	Loc. in Sec.
Anh.				NW NW SW
Tr.	<u>2186</u>			<div style="border: 2px solid red; padding: 5px; transform: rotate(-15deg); display: inline-block;"> Borden Towns Site Geol. Contr. McNab & Lin say Tools Pool /Estes </div>
Dg.				
Bl.				
L.				
K.C.				
B.K.C.				
Ce.				
C.				
M.				
M.				
K.				
Mz.				
Mo.				
V.				
S.				
S.				
A.				
R.				
PE.				
G.				
TD	<u>2245</u>			COMPLETE OCT 3 '56

Date Comm. SEP 19 '56
 Location 9-17-56
MIR SEP 26 '56 cr 2189-2229
5 1/2 2244 WOCT OCT 3 '56 CO/
48/2191-97 F12C 1X1 P.
25 Bopd + Tr. wtu.

County Cowley Elev. _____
 Sec. 1 Twp. 32 Rge. 6E
 Company Blair & Deputy
 Farm Name Youle No. 6

TOPS	DEPTH	LOG	DATUM	Loc. in Sec.
Anh.				NW NW SW
Tp.				
H.				
Tr.				
Dg.				
Bl.				
L.				Geol. _____
K.C.				Contr. _____
B.K.C.				
Ce.				
C.				McNab & Lind-
M.				say Tools
M.				Pool
K.				
Mz.				/Estes
Me.				
V.				
S.				
S.				
A.				
R.				
PE.				
G.				
T.D.				

Loc. in Sec. NW NW SW
 Geol. _____
 Contr. _____
 McNab & Lind-
 say Tools
 Pool
 /Estes
 SEP 12 1956
 FIRST REPORT

Date Comm. _____

Location _____

NOV 5 1956
 1956

30

Co.
 L. Sec.
 No.
 Sec.
 T.
 R.