

KANSAS


FORM 51 5M 1-42 PETROL

Ellsworth

Section 33 Township 16 Range 10-W

Well No. #3 Schroeder

Company Magnolia

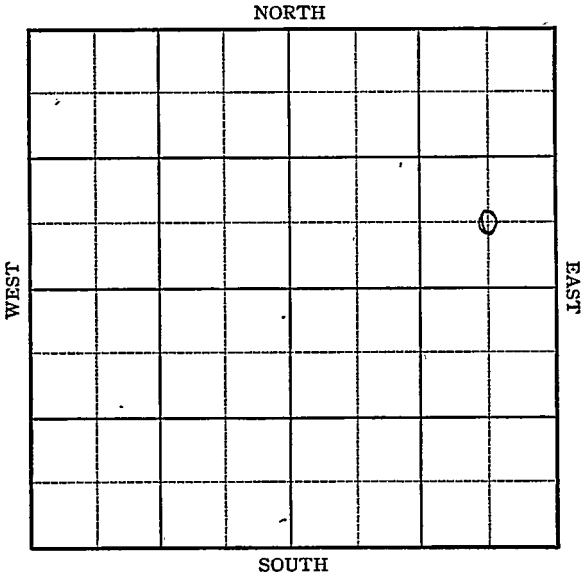

Sec. 33 Twp. 16 R. 10-W

Well No. #3 Schroeder Farm

Magnolia Company

Stoltemberg


 Ft. from N. Line

660 Ft. from S. Line

660 Ft. from E. Line

 Ft. from W. Line

Elev. 1821

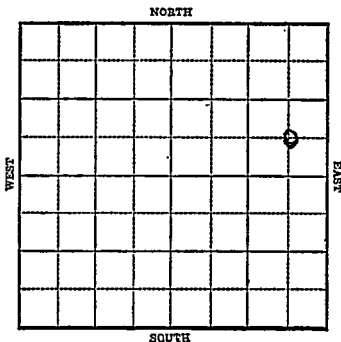

1943

R E P O R T

- 4/28 10" @ 251'
WOC.
- 5/5 Drlg. 2420'
- 5/12 Arb 3263-67 T.D.
6" @ 3264 Rust.
- 5/19 Arb. 3263
6" - 3264
P.B. 3285
2000 acid
Pump 259 Pot.
T.D. 3288
Gravity 43.4

COMPLETED

KANSAS Ellsworth
 Map No. 535 Sec. 33 Twp. 16 R. 10W

Well No. 3 Schroeder

Magnolia Company

FIRST REPORT

Contractor

C SE NE

SECTION PLAT

_____ Ft. from N. Line

660 Ft. from S. Line

660 Ft. from E. Line .

_____ Ft. from W. Line

			o

STOLTENBERG POOL

Location _____

Rig up _____

Drilling and Remarks:

10"-251'

W.O.C.

RECORD

Cased _____ in., _____ ft.

Sand _____

Gas _____

Oil _____

Total Depth _____

PRODUCTION

1st 24 hrs. Nat. _____

1st 24 hrs. after shot _____

Gas _____ Cu. Ft.

Dry Hole _____

Abandoned _____

Date

APR 28 1943 19

S. L. LEWIS Scout

Ellsworth

Map No. 55 Sec. 33 Twp. 16 R. 10W

Well No. 3 Schroeder

Magnolia Company

COMPLETED Contractor

C SE NE

SECTION PLAT

_____ Ft. from N. Line

660 Ft. from S. Line

660 Ft. from E. Line

_____ Ft. from W. Line

			o

STOLTENBERG POOL

Location _____

Rig up _____

Drilling and Remarks:

Cr 3263

6" c 3264

PA 3285

2000 acid

Pump 259 P & Y

484 Gr

RECORD -

Cased _____ in., _____ ft.

Sand _____

Gas _____

Oil _____

Total Depth 3288

PRODUCTION

1st 24 hrs: Nat. _____

1st 24 hrs. after shot _____

Gas _____ Cu. Ft.

Dry Hole _____

Abandoned _____

Date

MAY 19 1943

19

S. J. LEWIS Scout