

Cowley

**KANSAS**

SECTION 1 TOWNSHIP 32 RANGE 6 E

WELL NO. #1-A Youle SWD

COMPANY H. H. Blair & Paul Deputy

NORTH


WEST

EAST

0

SOUTH

Cowley

KANSAS

SEC. 1	TWP. 32	R. 6E
-----------	------------	----------

WELL NO.

#1-A Youle SWD

FARM

COMPANY

H.H. Blair & Paul Deputy

CONTRACTOR

Bedell & Cate

Estes


\_\_\_\_\_ Ft. from N. Line

\_\_\_\_\_ Ft. from S. Line

\_\_\_\_\_ Ft. from E. Line

\_\_\_\_\_ Ft. from W. Line

C E  $\frac{1}{2}$  NE SW

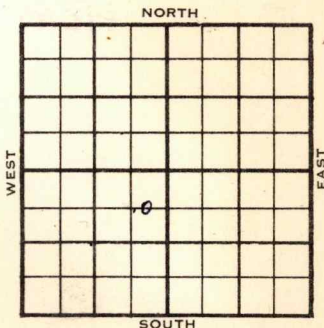

1955	ELEVATION 1341'	REPORT
------	--------------------	--------

12-28 Drlg. 1200

1956

1-11

10" @ 60  
7" @ 1748  
CO to 1800  
Comp. SWD well  
Input 300 bwpd  
Stal. 1738  
TD 1800'

ABANDONED



County Cowley Elev. \_\_\_\_\_  
 Sec. 1 Twp. 32 Rge. 6E  
 Company H. H. Blair & Paul Deputy  
 Farm Name Youle SWD No. 1-A

TOPS	DEPTH	LOG	DATUM
Anh.			
TP.			
H.			
Tr.			
Dg.			
BL.			
L.			
K.C.			
B.K.C.			
Ce.			
C.			
M.			
M.			
K.			
Mz.			
Mq.			
V.			
S.			
S.			
A.			
R.			
Pe.			
G.			
T.D.			

Loc. in Sec. C E  $\frac{1}{2}$  NE SW  
n  
 Geol. \_\_\_\_\_  
 Contr. Bedell & Cat  
 Pool \_\_\_\_\_  
Estes  
 FIRST REPORT  
 DEC 28 '56

Date Comm. drlg. 1200

*Handwritten notes:* 2.00

*Handwritten notes:* D.A.

Co.  
 No.  
 Sec.  
 T.  
 R.